

WATER WELL RECORD


Form WWC-5

Division of Water Resources App. No.

1 LOCATION OF WATER WELL: County: Shawnee Co. NE 1/4 NW 1/4 NW 1/4 Section Number 33 Township No. T 10 Range Number R 14

Street/Rural Address of Well Location; if unknown, distance & direction from nearest town or intersection: If at owner's address, check here. Global Positioning System (GPS) information: Latitude: Longitude: Elevation: Datum: Collection Method: Est. Accuracy:

2 WATER WELL OWNER: Randy Wolf RR#, Street Address, Box #: 5348 Silver Lake, Mo 64539 City, State, ZIP Code

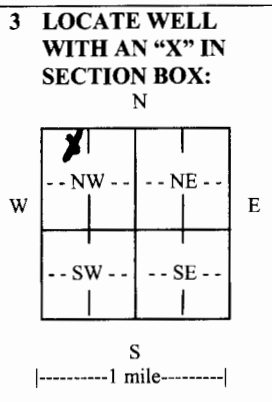

4 DEPTH OF COMPLETED WELL: 40' Depth(s) Groundwater Encountered (1) 20' (2) (3) WELL'S STATIC WATER LEVEL: 10' EST. YIELD: 1 1/2 gpm. Bore Hole Diameter: 10" to 40" WELL WATER TO BE USED AS: Domestic, Feedlot, Oil field water supply, Dewatering, Other (Specify below)

5 TYPE OF CASING USED: Steel, PVC, Other CASING JOINTS: Glued, Clamped, Welded, Threaded Casing diameter: 5" in. to 20" ft. Casing height above land surface: 20" in. Weight: 56.40 lbs./ft.

TYPE OF SCREEN OR PERFORATION MATERIAL: Steel, Stainless Steel, PVC, Brass, Galvanized Steel, None (open hole) SCREEN OR PERFORATION OPENINGS ARE: Continuous slot, Mill slot, Gauze wrapped, Torch cut, Drilled holes, Louvered shutter, Key punched, Wire wrapped, Saw cut, Other (specify) SCREEN-PERFORATED INTERVALS: From 20 ft. to 40 ft. GRAVEL PACK INTERVALS: From 20 ft. to 40 ft.

6 GROUT MATERIAL: Neat cement, Cement grout, Bentonite, Other Grout Intervals: From 0 ft. to 20 ft. What is the nearest source of possible contamination: None Close

Table with columns: FROM, TO, LITHOLOGIC LOG, FROM, TO, LITHO. LOG (cont.) or PLUGGING INTERVALS. Rows contain handwritten entries: 1-16 Brown Clay, 16-27 Sandy Clay & Fine Sand (WATER), 27-40 Gray Shale Dark Oil.

7 CONTRACTOR'S OR LANDOWNER'S CERTIFICATION: This water well was constructed, reconstructed, or plugged under my jurisdiction and was completed on (mo/day/year) 11/8/2012 and this record is true to the best of my knowledge and belief. Kansas Water Well Contractor's License No. 451. This Water Well Record was completed on (mo/day/year) 12/7/2012 under the business name of Redman Well Drilling by (signature) Craig H. Eubank

INSTRUCTIONS: Use typewriter or ball point pen. PLEASE PRESS FIRMLY and PRINT clearly. Please fill in blanks and check the correct answers. Send three copies (white, blue, pink) to Kansas Department of Health and Environment, Bureau of Water, Geology Section, 1000 SW Jackson St., Suite 420, Topeka, Kansas 66612-1367. Telephone 785-296-5524. Send one copy to WATER WELL OWNER and retain one for your records. Include fee of \$5.00 for each constructed well. Visit us at http://www.kdheks.gov/waterwell/index.html.