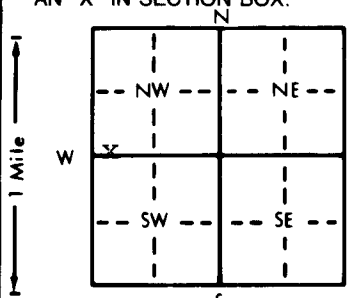


1 LOCATION OF WATER WELL: County: Shawnee Fraction: SW 1/4 SW 1/4 NW 1/4 Section Number: 13 Township Number: T 10 S Range Number: R 15 E

Distance and direction from nearest town or city street address of well if located within city?
1 1/2 North of Elmont

2 WATER WELL OWNER: Craig Scarlett
 RR#, St. Address, Box #: 7520 N.W Wilson Road Board of Agriculture, Division of Water Resources
 City, State, ZIP Code: Topeka, Kansas 66618 Application Number:

3 LOCATE WELL'S LOCATION WITH AN "X" IN SECTION BOX:  DEPTH OF COMPLETED WELL... 130 ft. ELEVATION:
 Depth(s) Groundwater Encountered 1. 100 ft. 2. 110 ft. 3. 120 ft.
 WELL'S STATIC WATER LEVEL 85 ft. below land surface measured on mo/day/yr 7-31-95
 Pump test data: Well water was ft. after hours pumping gpm
 Est. Yield 8 gpm: Well water was ft. after hours pumping gpm
 Bore Hole Diameter: 8 3/4 in. to 130 ft., and in. to ft.
 WELL WATER TO BE USED AS: 5 Public water supply 8 Air conditioning 11 Injection well
 1 Domestic 3 Feedlot 6 Oil field water supply 9 Dewatering 12 Other (Specify below)
 2 Irrigation 4 Industrial 7 Lawn and garden only 10 Monitoring well
 Was a chemical/bacteriological sample submitted to Department? Yes.....No X.....; If yes, mo/day/yr sample was submitted
 Water Well Disinfected? Yes X No

5 TYPE OF BLANK CASING USED: 1 Steel 2 PVC 3 RMP (SR) 4 ABS 5 Wrought iron 6 Asbestos-Cement 7 Fiberglass 8 Concrete tile 9 Other (specify below) CASING JOINTS: Glued X Clamped Welded Threaded
 Blank casing diameter 5 in. to 0-130 ft., Dia in. to ft., Dia in. to ft.
 Casing height above land surface 24 in., weight 2.82 lbs./ft. Wall thickness or gauge No. 258
 TYPE OF SCREEN OR PERFORATION MATERIAL: 1 Steel 2 Brass 3 Stainless steel 4 Galvanized steel 5 Fiberglass 6 Concrete tile 7 PVC 8 RMP (SR) 9 ABS 10 Asbestos-cement 11 Other (specify) 12 None used (open hole)
 SCREEN OR PERFORATION OPENINGS ARE: 1 Continuous slot 2 Louvered shutter 3 Mill slot 4 Key punched 5 Gauzed wrapped 6 Wire wrapped 7 Torch cut 8 Saw cut 9 Drilled holes 11 None (open hole)
 SCREEN-PERFORATED INTERVALS: From 90 ft. to 130 ft., From ft. to ft.
 GRAVEL PACK INTERVALS: From 24 ft. to 130 ft., From ft. to ft.

6 GROUT MATERIAL: 1 Neat cement 2 Cement grout 3 Bentonite 4 Other
 Grout Intervals: From 4 ft. to 24 ft., From ft. to ft.
 What is the nearest source of possible contamination: 1 Septic tank 2 Sewer lines 3 Watertight sewer lines 4 Lateral lines 5 Cess pool 6 Seepage pit 7 Pit privy 8 Sewage lagoon 9 Feedyard 10 Livestock pens 11 Fuel storage 12 Fertilizer storage 13 Insecticide storage 14 Abandoned water well 15 Oil well/Gas well 16 Other (specify below)
 Direction from well? Northy How many feet? 400

FROM	TO	LITHOLOGIC LOG	FROM	TO	PLUGGING INTERVALS
0	2	Brown clay	93	110	greyu sandstone
2	3	shaley brey limestone	110	111	grey limestone
3	9	yellow shale	111	112	grey shale
9	10	grey shale	112	115	grey sandstonwe
10	17	grey limestone	115	116	grey shale
17	18	grey shale	116	120	grey sandstone
18	21	grey limestone	120	125	grey shale
21	33	grey shale	125	128	grey limestone
33	34	grey limestonbe	128	130	grey sandstone
34	66	grey shale			
66	67	grey limestone			
67	74	grey shale			
74	85	shaley grey limestone			
85	87	grey sandstone			
87	93	grey shale			

7 CONTRACTOR'S OR LANDOWNER'S CERTIFICATION: This water well was (1) constructed, (2) reconstructed, or (3) plugged under my jurisdiction and was completed on (mo/day/year) 7-31-95 and this record is true to the best of my knowledge and belief. Kansas Water Well Contractor's License No. 182 This Water Well Record was completed on (mo/day/yr) 9-8-95 under the business name of Strader Drilling Co., Inc. by (signature) [Signature]

OFFICE USE ONLY
T
R
EW
SEC.
1/4
1/4
1/4