


1 LOCATION OF WATER WELL: County: SHAWNEE Fraction: SW 1/4 SE 1/4 SE 1/4 Section Number: 32 Township Number: T 10 S Range Number: R 15 E/W

Distance and direction from nearest town or city street address of well if located within city?  
2 miles north, 2 west of Topeka

2 WATER WELL OWNER: Don Guilbault  
 RR#, St. Address, Box #: 6000 NW 46th Board of Agriculture, Division of Water Resources  
 City, State, ZIP Code: Topeka, KS 66618 Application Number:

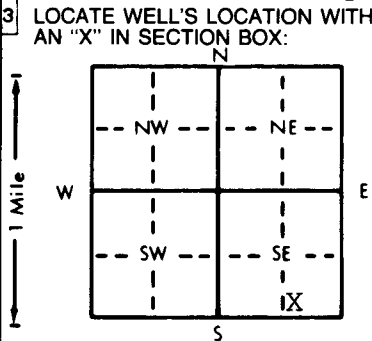

4 DEPTH OF COMPLETED WELL: 160' ft. ELEVATION:  
 Depth(s) Groundwater Encountered 1. 35' ft. 2. ft. 3. ft.  
 WELL'S STATIC WATER LEVEL: 22' ft. below land surface measured on mo/day/yr 09/24/98  
 Pump test data: Well water was ft. after hours pumping gpm  
 Est. Yield: 1 1/2 gpm: Well water was ft. after hours pumping gpm  
 Bore Hole Diameter: in. to ft., and in. to ft.  
 WELL WATER TO BE USED AS:  
 5 Public water supply 8 Air conditioning 11 Injection well  
 1 Domestic 3 Feedlot 6 Oil field water supply 9 Dewatering 12 Other (Specify below)  
 2 Irrigation 4 Industrial 7 Lawn and garden only 10 Monitoring well  
 Was a chemical/bacteriological sample submitted to Department? Yes No X; If yes, mo/day/yr sample was submitted  
 Water Well Disinfected? Yes X No

5 TYPE OF BLANK CASING USED:  
 1 Steel 3 RMP (SR) 5 Wrought iron 8 Concrete tile CASING JOINTS: Glued X Clamped  
 2 PVC 4 ABS 6 Asbestos-Cement 9 Other (specify below) Welded  
 7 Fiberglass Threaded  
 Blank casing diameter: 5" in. to 0-25 ft., Dia. 5" in. to 85-110 ft., Dia. 5" in. to 120-158 ft.  
 Casing height above land surface: 24" in., weight 2.82 lbs./ft. Wall thickness or gauge No. 258  
 TYPE OF SCREEN OR PERFORATION MATERIAL:  
 1 Steel 3 Stainless steel 5 Fiberglass 7 PVC 10 Asbestos-cement  
 2 Brass 4 Galvanized steel 6 Concrete tile 8 RMP (SR) 11 Other (specify)  
 12 None used (open hole)  
 SCREEN OR PERFORATION OPENINGS ARE:  
 1 Continuous slot 3 Mill slot 5 Gauzed wrapped 8 Saw cut 11 None (open hole)  
 2 Louvered shutter 4 Key punched 6 Wire wrapped 9 Drilled holes  
 7 Torch cut 10 Other (specify)  
 SCREEN-PERFORATED INTERVALS: From 25 ft. to 85 ft., From 110 ft. to 120 ft.  
 From 158 ft. to 160 ft., From ft. to ft.  
 GRAVEL PACK INTERVALS: From 24 ft. to 160 ft., From ft. to ft.  
 From ft. to ft., From ft. to ft.

6 GROUT MATERIAL: 1 Neat cement 2 Cement grout 3 Bentonite 4 Other  
 Grout Intervals: From 4 ft. to 24 ft., From ft. to ft., From ft. to ft.  
 What is the nearest source of possible contamination:  
 1 Septic tank 4 Lateral lines 7 Pit privy 10 Livestock pens 14 Abandoned water well  
 2 Sewer lines 5 Cess pool 8 Sewage lagoon 11 Fuel storage 15 Oil well/Gas well  
 3 Watertight sewer lines 6 Seepage pit 9 Feedyard 12 Fertilizer storage 16 Other (specify below)  
 13 Insecticide storage  
 Direction from well? WEST How many feet? 195'

FROM	TO	LITHOLOGIC LOG	FROM	TO	PLUGGING INTERVALS
0	5	Clay-Brown	97	98	Shale-Grey
5	20	Shaley	98	99	Limestone-Grey
20	23	Shale-Grey	99	101	Shale-Grey
23	25	Sandstone-Brown	101	103	Limestone-Grey
25	35	Sandstone-Grey	103	110	Shale-Grey
35	44	Shale-Grey	110	117	Sandstone-Grey
44	53	Sandstone-Grey	117	131	Shale-Grey
53	55	Shale-Grey	131	132	Limestone-Grey
55	58	Sandstone-Grey	132	148	Shale-Grey
58	64	Shale-Grey	148	152	Limestone-Grey
64	68	Sandstone-Grey	152	154	Shale-Blk
68	77	Sandstone-Grey	154	160	Shaley LS-Grey
77	88	Shale-Grey			
88	93	Shaley LS			
93	97	Limestone-Grey			

7 CONTRACTOR'S OR LANDOWNER'S CERTIFICATION: This water well was (1) constructed, (2) reconstructed, or (3) plugged under my jurisdiction and was completed on (mo/day/year) 09/24/98 and this record is true to the best of my knowledge and belief. Kansas Water Well Contractor's License No. 182 This Water Well Record was completed on (mo/day/yr) 10-9-98 under the business name of STRADER DRILLING CO., INC. by (signature) Dale Strader

OFFICE USE ONLY  
T  
R  
E/W  
SEC  
1/4  
1/4  
1/4