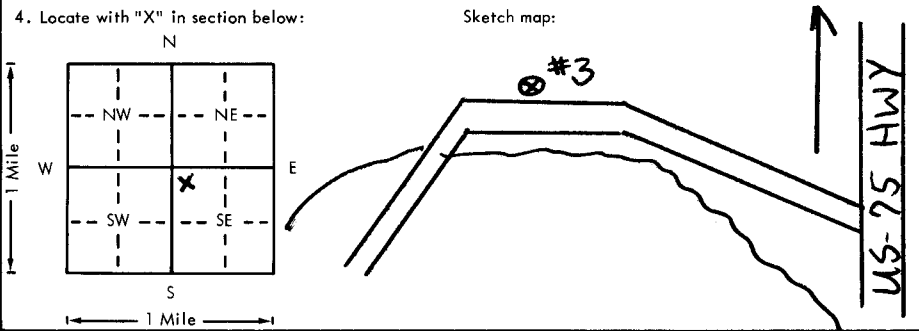


USE TYPEWRITER OR BALL POINT PEN-PRESS FIRMLY, PRINT CLEARLY.

WATER WELL RECORD
KSA 82a-1201-1215

Kansas Department of Health and Environment-Division of Environment (Water well Contractors) Topeka, Kansas 66620

1. Location of well: County SHAWNEE Fraction NW 1/4 NW 1/4 SE 1/4 Section number 15 Township number T 10 S Range number R 15 EW	
2. Distance and direction from nearest town or city: 6 mi N. Topeka 3. Owner of well: Topeka Waste Systems R.R. or street: Building 2704 Supply Depot Forbes AFB City, state, zip code: Topeka, KS. 666019	
4. Locate with "X" in section below:  Sketch map: US-75 HWY	
5. Type and color of material	
Rubble Fill	From 0 To 17
6. Bore hole dia. 12 in. Completion date 7-3-79 Well depth 17 ft.	
7. <input checked="" type="checkbox"/> Cable tool <input checked="" type="checkbox"/> Rotary <input type="checkbox"/> Driven <input type="checkbox"/> Dug <input type="checkbox"/> Hollow rod <input type="checkbox"/> Jetted <input type="checkbox"/> Bored <input type="checkbox"/> Reverse rotary	
8. Use: <input type="checkbox"/> Domestic <input type="checkbox"/> Public supply <input type="checkbox"/> Industry <input type="checkbox"/> Irrigation <input type="checkbox"/> Air conditioning <input type="checkbox"/> Stock <input type="checkbox"/> Lawn <input type="checkbox"/> Oil field water <input checked="" type="checkbox"/> Other	
9. Casing: Material Steel Height: Above or below Threaded <input type="checkbox"/> Welded <input checked="" type="checkbox"/> Surface 12 in. RMP <input type="checkbox"/> PVC <input type="checkbox"/> Weight 5.6 lbs./ft. Dia. 4 in. to 7 ft. depth Wall Thickness: inches or Dia. <input type="checkbox"/> in. to <input type="checkbox"/> ft. depth gage No. 0.120	
10. Screen: Manufacturer's name Johnson Type Wire Wound Dia. 4 in. Slot/gauze 0.010 Length 10 ft. Set between 7 ft. and 17 ft. Gravel pack? yes Size range of material 1/8" - 1/4"	
11. Static water level: None recorded mo./day/yr. ft. below land surface Date	
12. Pumping level below land surfaces: Observation well ft. after hrs. pumping g.p.m. Estimated maximum yield g.p.m.	
13. Water sample submitted: mo./day/yr. Yes <input checked="" type="checkbox"/> No <input type="checkbox"/> Date	
14. Well head completion: Pitless adapter 12 Inches above grade	
15. Well grouted? yes With: <input checked="" type="checkbox"/> Neat cement <input type="checkbox"/> Bentonite <input type="checkbox"/> Concrete Depth: From 0 ft. to 7 ft.	
16. Nearest source of possible contamination: See note ft. Direction Type Well disinfected upon completion? <input checked="" type="checkbox"/> Yes <input type="checkbox"/> No	
17. Pump: <input checked="" type="checkbox"/> Not installed Manufacturer's name Model number HP Volts Length of drop pipe ft. capacity g.p.m. Type: <input type="checkbox"/> Submersible <input type="checkbox"/> Turbine <input type="checkbox"/> Jet <input type="checkbox"/> Reciprocating <input type="checkbox"/> Centrifugal <input type="checkbox"/> Other	
(Use a second sheet if needed)	
18. Elevation: 1017.0 Topography: <input checked="" type="checkbox"/> Hill <input type="checkbox"/> Slope <input type="checkbox"/> Upland <input type="checkbox"/> Valley	19. Remarks: Observation Well #3 (#4)
20. Water well contractor's certification: This well was drilled under my jurisdiction and this report is true to the best of my knowledge and belief. Layne-Western Co., Inc 149 Business name License No. Address 1040 W St 3975 K.G.Mo. Signed W.D. Higgins Date 3/7/80 Authorized representative	

Forward the white, blue and pink copies to the Department of Health and Environment

Form WWC-5

not in file

T
R
E
S
E
C
1/4
1/4
1/4