


1 LOCATION OF WATER WELL: County: Shawnee	Fraction SW 1/4 SE 1/4 SE 1/4	Section Number 15	Township Number T 10 S	Range Number R 15 EW
---	---	-----------------------------	----------------------------------	--------------------------------

Distance and direction from nearest town or city street address of well if located within city?
6 miles north of Topeka

2 WATER WELL OWNER: **Waste Management, Inc.**
 RR#, St. Address, Box # : **3003 Butterfield Rd.**
 City, State, ZIP Code : **Oakbrook, IL 60521**
 Board of Agriculture, Division of Water Resources
 Application Number:

3 LOCATE WELL'S LOCATION WITH AN "X" IN SECTION BOX:
 4 DEPTH OF COMPLETED WELL: **92.0** ft. ELEVATION: **1072.5 (ground)**

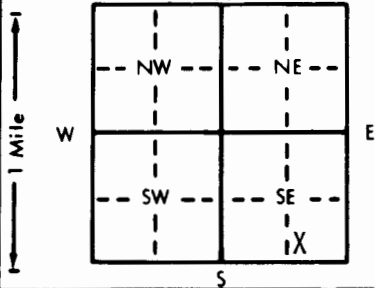

Depth(s) Groundwater Encountered 1. **None** ft. 2. ft. 3. ft.
 WELL'S STATIC WATER LEVEL **None** ft. below land surface measured on mo/day/yr
 Pump test data: Well water was ft. after hours pumping gpm
 Est. Yield gpm: Well water was ft. after hours pumping gpm
 Bore Hole Diameter: **8** in. to **92.0** ft., and in. to ft.
 WELL WATER TO BE USED AS:
 5 Public water supply 8 Air conditioning 11 Injection well
 1 Domestic 3 Feedlot 6 Oil field water supply 9 Dewatering **12 Other (Specify below)**
 2 Irrigation 4 Industrial 7 Lawn and garden only 10 Observation well **Monitoring Well**
 Was a chemical/bacteriological sample submitted to Department? Yes No **X**; If yes, mo/day/yr sample was submitted
 Water Well Disinfected? Yes No **X**

5 TYPE OF BLANK CASING USED:
 1 Steel 3 RMP (SR) 5 Wrought iron 8 Concrete tile CASING JOINTS: Glued Clamped
2 PVC 4 ABS 6 Asbestos-Cement 9 Other (specify below) Welded
 7 Fiberglass Threaded **X**

Blank casing diameter **4** in. to **92.0** ft., Dia in. to ft., Dia in. to ft.
 Casing height above land surface in., weight lbs./ft. Wall thickness or gauge No.

TYPE OF SCREEN OR PERFORATION MATERIAL:
 1 Steel 3 Stainless steel 5 Fiberglass **7 PVC** 10 Asbestos-cement
 2 Brass 4 Galvanized steel 6 Concrete tile 9 ABS 11 Other (specify)
 SCREEN OR PERFORATION OPENINGS ARE:
 1 Continuous slot **3 Mill slot** 5 Gauzed wrapped 8 Saw cut 11 None (open hole)
 2 Louvered shutter 4 Key punched 6 Wire wrapped 9 Drilled holes
 7 Torch cut 10 Other (specify)

SCREEN-PERFORATED INTERVALS: From **57.0** ft. to **92.0** ft., From ft. to ft.
 From ft. to ft., From ft. to ft.
 GRAVEL PACK INTERVALS: From **56.0** ft. to **92.0** ft., From ft. to ft.
 From ft. to ft., From ft. to ft.

6 GROUT MATERIAL: 1 Neat cement **2 Cement grout** **3 Bentonite** 4 Other
 Grout Intervals #3 From **54.0** ft. to **56.0** ft. #2 From **0.0** ft. to **54.0** ft., From ft. to ft.
 What is the nearest source of possible contamination:
 1 Septic tank 4 Lateral lines 7 Pit privy 10 Livestock pens 14 Abandoned water well
 2 Sewer lines 5 Cess pool 8 Sewage lagoon 11 Fuel storage 15 Oil well/Gas well
 3 Watertight sewer lines 6 Seepage pit 9 Feedyard 12 Fertilizer storage **16 Other (specify below)**
Landfill
 Direction from well? **north** How many feet? **80**

FROM	TO	LITHOLOGIC LOG	FROM	TO	LITHOLOGIC LOG
0.0	2.0	Topsoil			
2.0	3.0	Clay, Brown			
3.0	5.0	Limestone, Brown			
5.0	19.0	Shale, Yellow			
19.0	21.0	Limestone, Brown			
21.0	41.0	Shale, Gray			
41.0	47.0	Limestone, Gray			
47.0	62.0	Shale, Gray			
62.0	67.0	Limestone, Gray			
67.0	69.0	Shale, Gray			
69.0	70.0	Limestone, Gray			
70.0	80.0	Shale, Gray			
80.0	83.0	Limestone, Gray			
83.0	85.0	Shale, Gray			
85.0	92.0	Limestone, Gray			

7 CONTRACTOR'S OR LANDOWNER'S CERTIFICATION: This water well was **1** constructed, (2) reconstructed, or (3) plugged under my jurisdiction and was completed on (mo/day/year) **7/31/84** and this record is true to the best of my knowledge and belief. Kansas Water Well Contractor's License No. **416**. This Water Well Record was completed on (mo/day/yr) **10/18/84** by (signature) *[Signature]* under the business name of **Terracon Consultants, Inc.**

INSTRUCTIONS: Use typewriter or ball point pen, PLEASE PRESS FIRMLY and PRINT clearly. Please fill in blanks, underline or circle the correct answers. Send top three copies to Kansas Department of Health and Environment, Division of Environment, Environmental Geology Section, Topeka, KS 66620. Send one to WATER WELL OWNER and retain one for your records.

OFFICE USE ONLY
T
R
EW
SEC.
1/4
1/4
1/4