


1] LOCATION OF WATER WELL: County: Shawnee Section Number: 15 Township Number: T 10 S Range Number: R 15 EW

Distance and direction from nearest town or city street address of well if located within city?
7 1/2 miles north of Topeka KS

2] WATER WELL OWNER: WMI Rolling meadows landfill
 RR#, St. Address, Box #: 7351 NW Highway 75
 City, State, ZIP Code: Topeka KS 66618
 Board of Agriculture, Division of Water Resources
 Application Number:

3] LOCATE WELL'S LOCATION WITH AN "X" IN SECTION BOX:
 4] DEPTH OF COMPLETED WELL: 63.3 ft. ELEVATION: ≈ 10.71

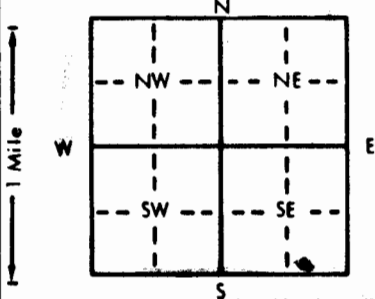

Depth(s) Groundwater Encountered 1. ft. 2. ft. 3. ft.
 WELL'S STATIC WATER LEVEL ft. below land surface measured on mo/day/yr
 Pump test data: Well water was ft. after hours pumping gpm
 Est. Yield gpm: Well water was ft. after hours pumping gpm
 Bore Hole Diameter . . . 6 in. to 63.3 ft., and in. to ft.
 WELL WATER TO BE USED AS: 5 Public water supply 8 Air conditioning 11 Injection well
 1 Domestic 3 Feedlot 6 Oil field water supply 9 Dewatering 12 Other (Specify below)
 2 Irrigation 4 Industrial 7 Lawn and garden only 10 Observation well
 Was a chemical/bacteriological sample submitted to Department? Yes. No; If yes, mo/day/yr sample was sub-
 mitted Water Well Disinfected? Yes No

5] TYPE OF BLANK CASING USED: 5 Wrought iron 8 Concrete tile CASING JOINTS: Glued Clamped
 1 Steel 3 RMP (SR) 6 Asbestos-Cement 9 Other (specify below) Welded
2 PVC 4 ABS 7 Fiberglass Threaded
 Blank casing diameter . . . 2 in. to 58.3 ft., Dia in. to ft., Dia in. to ft.
~~Casing weight above land surface~~ 21.75 in., weight lbs./ft. Wall thickness or gauge No. 5.6 40

TYPE OF SCREEN OR PERFORATION MATERIAL: 7 PVC 10 Asbestos-cement
 1 Steel 3 Stainless steel 5 Fiberglass 8 RMP (SR) 11 Other (specify)
 2 Brass 4 Galvanized steel 6 Concrete tile 9 ABS 12 None used (open hole)

SCREEN OR PERFORATION OPENINGS ARE: 5 Gauzed wrapped 8 Saw cut 11 None (open hole)
Continuous slot 3 Mill slot 6 Wire wrapped 9 Drilled holes
 2 Louvered shutter 4 Key punched 7 Torch cut 10 Other (specify)

SCREEN-PERFORATED INTERVALS: From . . . 58.3 ft. to 62.3 ft., From ft. to ft.
 From . . . ~~58.3~~ ft. to ~~62.3~~ ft., From ft. to ft.
 GRAVEL PACK INTERVALS: From . . . 57.5 ft. to 63.3 ft., From ft. to ft.
 From ft. to ft., From ft. to ft.

6] GROUT MATERIAL: 1 Neat cement 2 Cement grout 3 Bentonite 4 Other
 Grout intervals: From . . . 55.3 ft. to 57.5 ft., From 57.5 ft. to 63.3 ft., From ft. to ft.
 What is the nearest source of possible contamination: 10 Livestock pens 14 Abandoned water well
 1 Septic tank 4 Lateral lines 7 Pit privy 11 Fuel storage 15 Oil well/Gas well
 2 Sewer lines 5 Cess pool 8 Sewage lagoon 12 Fertilizer storage 16 Other (specify below)
 3 Watertight sewer lines 6 Seepage pit 9 Feedyard 13 Insecticide storage Landfill
 Direction from well? NW How many feet? 1200

FROM	TO	LITHOLOGIC LOG	FROM	TO	LITHOLOGIC LOG
0	15.1	Top soil / clay / weathered green shale	58.6	62.4	Limestone, Light gray to 60.1' Dark gray w/ shale partings
15.1	17.9	Limestone, gray brown w/ clay seams	62.4	63.3	Shale, green-gray
17.9	29.5	shale dark gray	<div style="border: 2px solid black; padding: 10px; font-size: 2em; font-weight: bold; transform: rotate(-2deg); display: inline-block;">RECEIVED</div> OCT 12 1989 DIVISION OF ENVIRONMENT		
29.5	39.1	Limestone, gray, fine grained fossiliferous			
39.1	58.6	shale dark gray			

7] CONTRACTOR'S OR LANDOWNER'S CERTIFICATION: This water well was (1) constructed (2) reconstructed, or (3) plugged under my jurisdiction and was completed on (mo/day/year) 8/30/89 and this record is true to the best of my knowledge and belief. Kansas Water Well Contractor's License No. 438 This Water Well Record was completed on (mo/day/yr) 9-10-89 under the business name of Kansas City Testing Lab by (signature) R C Leeds