

B-1A


WATER WELL RECORD Form WWC-5 KSA 82a-1212

1 LOCATION OF WATER WELL: County: Shawnee Fraction: SW 1/4 SE 1/4 SE 1/4 Section Number 15 Township Number T 10 S Range Number R 15 EW

Distance and direction from nearest town or city street address of well if located within city? 7 1/2 miles north of Topeka, Kansas

2 WATER WELL OWNER: WMI - Rolling Meadows Landfill RR#, St. Address, Box #: 7351 NW Highway 75 Topeka KS 66618 Board of Agriculture, Division of Water Resources Application Number:

3 LOCATE WELL'S LOCATION WITH AN "X" IN SECTION BOX:

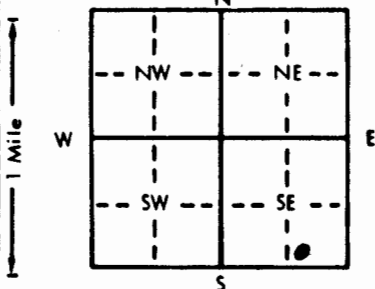

4 DEPTH OF COMPLETED WELL: 75.8' ft. ELEVATION: ~1072' Depth(s) Groundwater Encountered 1... ft. 2... ft. 3... ft. WELL'S STATIC WATER LEVEL... ft. below land surface measured on mo/day/yr Pump test data: Well water was... ft. after... hours pumping... gpm Est. Yield... gpm Well water was... ft. after... hours pumping... gpm Bore Hole Diameter... 6... in. to 75.8'... ft., and... in. to... ft. WELL WATER TO BE USED AS: 5 Public water supply 8 Air conditioning 11 Injection well 1 Domestic 3 Feedlot 6 Oil field water supply 9 Dewatering 12 Other (Specify below) 2 Irrigation 4 Industrial 7 Lawn and garden only 10 Observation well Was a chemical/bacteriological sample submitted to Department? Yes... No... If yes, mo/day/yr sample was submitted Water Well Disinfected? Yes No

5 TYPE OF BLANK CASING USED: 1 Steel 3 RMP (SR) 5 Wrought iron 8 Concrete tile CASING JOINTS: Glued... Clamped... 2 PVC 4 ABS 6 Asbestos-Cement 9 Other (specify below) Welded... Threaded... Blank casing diameter... 2... in. to... ft., Dia... in. to... ft., Dia... in. to... ft., Dia... lbs./ft. Wall thickness or gauge No. Sch 40

TYPE OF SCREEN OR PERFORATION MATERIAL: 1 Steel 3 Stainless steel 5 Fiberglass 8 RMP (SR) 10 Asbestos-cement 2 Brass 4 Galvanized steel 6 Concrete tile 9 ABS 11 Other (specify) 12 None used (open hole)

SCREEN OR PERFORATION OPENINGS ARE: 1 Continuous slot 3 Mill slot 5 Gauzed wrapped 8 Saw cut 11 None (open hole) 2 Louvered shutter 4 Key punched 6 Wire wrapped 9 Drilled holes 10 Other (specify)

SCREEN-PERFORATED INTERVALS: From 65.8... ft. to 74.8... ft., From... ft. to... ft., From... ft. to... ft., From... GRAVEL PACK INTERVALS: From 64.1... ft. to 74.8... ft., From... ft. to... ft., From... ft. to... ft., From...

6 GROUT MATERIAL: 1 Neat cement 2 Cement grout 3 Bentonite 4 Other Grout Intervals: From 61.5... ft. to 64.5... ft., From 67.5... ft. to surface... ft., From... ft. to... ft.

What is the nearest source of possible contamination: 1 Septic tank 4 Lateral lines 7 Pit privy 10 Livestock pens 14 Abandoned water well 2 Sewer lines 5 Cess pool 8 Sewage lagoon 11 Fuel storage 15 Oil well/Gas well 3 Watertight sewer lines 6 Seepage pit 9 Feedyard 12 Fertilizer storage 16 Other (specify below) Landfill Direction from well? NW How many feet? 1200

Table with 4 columns: FROM, TO, LITHOLOGIC LOG, FROM, TO, LITHOLOGIC LOG. Rows describe geological layers from 0 to 62.4 feet depth, including topsoil, limestone, shale, and weathered limestone.

7 CONTRACTOR'S OR LANDOWNER'S CERTIFICATION: This water well was (1) constructed, (2) reconstructed, or (3) plugged under my jurisdiction and was completed on (mo/day/year) 9/30/89 and this record is true to the best of my knowledge and belief. Kansas Water Well Contractor's License No. 438 This Water Well Record was completed on (mo/day/yr) 9-10-89 under the business name of Kansas City Testing Lab by (signature) RC Leads

INSTRUCTIONS: Use typewriter or ball point pen. PLEASE PRESS FIRMLY and PRINT clearly. Please fill in blanks, underline or circle the correct answers. Send top three copies to Kansas Department of Health and Environment, Bureau of Water Protection, Topeka, Kansas 66606. Telephone: 913-862-9360. Send one to WATER WELL OWNER and retain one for your records.

