


1 LOCATION OF WATER WELL:	Fraction	Section Number	Township Number	Range Number
County: Shawnee	1/4 1/4 SE 1/4	15	T 10S S	R 15E E/W

Distance and direction from nearest town or city street address of well if located within city?
8 miles

2 WATER WELL OWNER: Rolling Meadows Landfill
 RR#, St. Address, Box #: 7351 NW Highway 75 Board of Agriculture, Division of Water Resources
 City, State, ZIP Code: Topeka, KS 66618 Application Number: NA

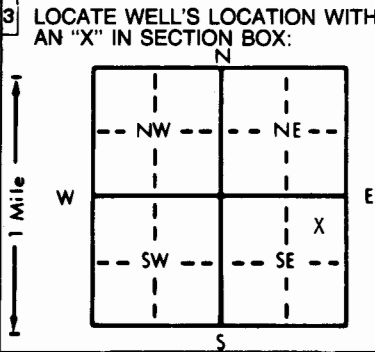

4 DEPTH OF COMPLETED WELL: 88.5 ft. ELEVATION: 1089.9 ft.
 Depth(s) Groundwater Encountered: 1. 31.0 ft. 2. ft. 3. ft.
 WELL'S STATIC WATER LEVEL: ft. below land surface measured on mo/day/yr
 Pump test data: Well water was ft. after hours pumping gpm
 Est. Yield gpm: Well water was ft. after hours pumping gpm
 Bore Hole Diameter: 6 in. to ft., and in. to ft.
 WELL WATER TO BE USED AS:
 5 Public water supply 8 Air conditioning 11 Injection well
 1 Domestic 3 Feedlot 6 Oil field water supply 9 Dewatering 12 Other (Specify below)
 2 Irrigation 4 Industrial 7 Lawn and garden only 10 Observation well Monitoring Well
 Was a chemical/bacteriological sample submitted to Department? Yes.....No.....; If yes, mo/day/yr sample was sub-
 mitted Water Well Disinfected? Yes No

5 TYPE OF BLANK CASING USED:
 1 Steel 3 RMP (SR) 5 Wrought iron 8 Concrete tile CASING JOINTS: Glued Clamped
 2 PVC 4 ABS 6 Asbestos-Cement 9 Other (specify below) Welded
 7 Fiberglass Threaded
 Blank casing diameter: 2 in. to ft., Dia. in. to ft., Dia. in. to ft.
 Casing height above land surface: 2.5 in., weight lbs./ft. Wall thickness or gauge No. SCH. 40
 TYPE OF SCREEN OR PERFORATION MATERIAL:
 1 Steel 3 Stainless steel 5 Fiberglass 7 PVC 10 Asbestos-cement
 2 Brass 4 Galvanized steel 6 Concrete tile 8 RMP (SR) 11 Other (specify)
 9 ABS 12 None used (open hole)
 SCREEN OR PERFORATION OPENINGS ARE:
 1 Continuous slot 3 Mill slot 5 Gauzed wrapped 8 Saw cut 11 None (open hole)
 2 Louvered shutter 4 Key punched 6 Wire wrapped 9 Drilled holes
 7 Torch cut 10 Other (specify)
 SCREEN-PERFORATED INTERVALS: From 88.5 ft. to 78.3 ft., From ft. to ft.
 From ft. to ft., From ft. to ft.
 GRAVEL PACK INTERVALS: From 88.5 ft. to 78.0 ft., From ft. to ft.
 From ft. to ft., From ft. to ft.

6 GROUT MATERIAL: 1 Neat cement 2 Cement grout 3 Bentonite 4 Other Cement/Bentonite
 Grout Intervals: From 71.5 ft. to 0.0 ft., From ft. to ft.
 What is the nearest source of possible contamination:
 1 Septic tank 4 Lateral lines 7 Pit privy 10 Livestock pens 14 Abandoned water well
 2 Sewer lines 5 Cess pool 8 Sewage lagoon 11 Fuel storage 15 Oil well/Gas well
 3 Watertight sewer lines 6 Seepage pit 9 Feedyard 12 Fertilizer storage 16 Other (specify below)
 13 Insecticide storage NA

Direction from well? How many feet?

FROM	TO	LITHOLOGIC LOG	FROM	TO	LITHOLOGIC LOG
0	12	Spoil/shale		88.5	Bottom of hole
12	14.5	Limestone, hard buff			
14.5	28.5	Shale, gray-green, soft clayey			
28.5	31.0	Limestone, yellow weathered brown seams			
31.0	32.5	Shale, dark gray, wet			
32.5	33.5	Limestone, dark gray			
33.5	39.0	Shale, dark gray			
39.0	39.5	Limestone, dark gray, argillaceous			
39.5	51.0	Shale, dark gray, calcareous			
51.0	53.0	Limestone, dark gray			
53.0	68.5	Shale, dark gray, calcareous			
68.5	72.0	Limestone, hard gray			
72.0	77.5	Shale, green calcareous			
77.5	83.5	Limestone, hard gray shale seam			
83.5	88.5	Shale, calcareous green to limestone argillaceous			

7 CONTRACTOR'S OR LANDOWNER'S CERTIFICATION: This water well was (1) constructed, (2) reconstructed, or (3) plugged under my jurisdiction and was completed on (mo/day/year) 8/14/90 and this record is true to the best of my knowledge and belief. Kansas Water Well Contractor's License No. 481 This Water Well Record was completed on (mo/day/yr) 5/14/92 under the business name of John Mathes & Associates, Inc. by (signature) Charles W. Robert

INSTRUCTIONS: Use typewriter or ball point pen. PLEASE PRESS FIRMLY and PRINT clearly. Please fill in blanks, underline or circle the correct answers. Send top three copies to Kansas Department of Health and Environment, Bureau of Water Protection, Topeka, Kansas 66620-7320, Telephone: 913-862-9360. Send one to WATER WELL OWNER and retain one for your records.