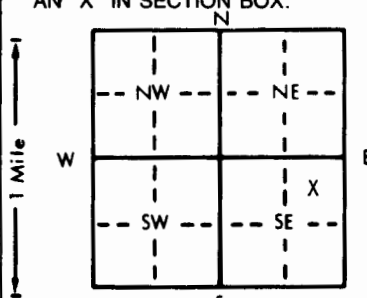


1 LOCATION OF WATER WELL: Fraction $\frac{1}{4}$ $\frac{1}{4}$ SE $\frac{1}{4}$ Section Number 15 Township Number T 10S S Range Number R 15E EW
 County: Shawnee

Distance and direction from nearest town or city street address of well if located within city?
 8 miles

2 WATER WELL OWNER: Rolling Meadows Landfill
 RR#, St. Address, Box #: 7351 NW Highway 75 Board of Agriculture, Division of Water Resources
 City, State, ZIP Code: Topeka, KS 66618 Application Number: NA

3 LOCATE WELL'S LOCATION WITH AN "X" IN SECTION BOX:

 4 DEPTH OF COMPLETED WELL: 69.9 ft. ELEVATION: 1086.1
 Depth(s) Groundwater Encountered 1. ft. 2. ft. 3. ft.
 WELL'S STATIC WATER LEVEL ft. below land surface measured on mo/day/yr
 Pump test data: Well water was ft. after hours pumping gpm
 Est. Yield gpm: Well water was ft. after hours pumping gpm
 Bore Hole Diameter . . . 6. in. to ft., and in. to ft.
 WELL WATER TO BE USED AS: 5 Public water supply 8 Air conditioning 11 Injection well
 1 Domestic 3 Feedlot 6 Oil field water supply 9 Dewatering 12 Other (Specify below)
 2 Irrigation 4 Industrial 7 Lawn and garden only 10 Monitoring well Monitoring Well
 Was a chemical/bacteriological sample submitted to Department? Yes No ; If yes, mo/day/yr sample was submitted
 Water Well Disinfected? Yes No

5 TYPE OF BLANK CASING USED:
 1 Steel 3 RMP (SR) 5 Wrought iron 8 Concrete tile CASING JOINTS: Glued Clamped
 2 PVC 4 ABS 6 Asbestos-Cement 9 Other (specify below) Welded
 Threaded
 Blank casing diameter . . 2. in. to ft., Dia in. to ft., Dia in. to ft.
 Casing height above land surface . . 2.5 in., weight lbs./ft. Wall thickness or gauge No. Sch .40
 TYPE OF SCREEN OR PERFORATION MATERIAL:
 1 Steel 3 Stainless steel 5 Fiberglass 8 RMP (SR) 10 Asbestos-cement
 2 Brass 4 Galvanized steel 6 Concrete tile 9 ABS 11 Other (specify)
 12 None used (open hole)
 SCREEN OR PERFORATION OPENINGS ARE:
 1 Continuous slot 3 Mill slot 5 Gauzed wrapped 8 Saw cut 11 None (open hole)
 2 Louvered shutter 4 Key punched 6 Wire wrapped 9 Drilled holes
 7 Torch cut 10 Other (specify)
 SCREEN-PERFORATED INTERVALS: From . . . 69.9 ft. to . . . 64.9 ft., From ft. to ft.
 From ft. to ft., From ft. to ft.
 GRAVEL PACK INTERVALS: From . . . 69.9 ft. to . . . 64.5 ft., From ft. to ft.
 From ft. to ft., From ft. to ft.

6 GROUT MATERIAL: 1 Neat cement 2 Cement grout 3 Bentonite 4 Other . . . Cement/Bentonite
 Grout Intervals: From . . 61.3 ft. to . . 0.0 ft., From ft. to ft.
 What is the nearest source of possible contamination:
 1 Septic tank 4 Lateral lines 7 Pit privy 10 Livestock pens 14 Abandoned water well
 2 Sewer lines 5 Cess pool 8 Sewage lagoon 11 Fuel storage 15 Oil well/Gas well
 3 Watertight sewer lines 6 Seepage pit 9 Feedyard 12 Fertilizer storage 16 Other (specify below)
 13 Insecticide storage NA
 Direction from well? How many feet?

FROM	TO	LITHOLOGIC LOG	FROM	TO	PLUGGING INTERVALS
0	10	Spoil/shale			
10	12.5	Limestone, buff wet			
12.5	24.5	Shale, soft gray-green, very clayey @ 20'			
24.5	27.0	Limestone, brown hard with weathered seams			
27.0	64.0	Shale, dark gray calcareous with limestone			
64.0	67.3	Limestone, hard yellow, shale seam @ 66'			
67.3	70.0	Shale, gray-green			
	70.0	Bottom of hole			

7 CONTRACTOR'S OR LANDOWNER'S CERTIFICATION: This water well was (1) constructed, (2) reconstructed, or (3) plugged under my jurisdiction and was completed on (mo/day/year) . . . 8/13/90 and this record is true to the best of my knowledge and belief. Kansas Water Well Contractor's License No. . . . 481 This Water Well Record was completed on (mo/day/yr) . . 5/14/92 under the business name of John Mathes & Associates, Inc. by (signature) *Charles W. Roberts*

OFFICE USE ONLY
 T
 R
 EW
 SEC.
 1/4
 1/4
 1/4