


1 LOCATION OF WATER WELL: County: Shawnee Fraction: 1/4 1/4 SE 1/4 Section Number: 15 Township Number: T 105 S Range Number: R 15E E/W

Distance and direction from nearest town or city street address of well if located within city?  
8 miles

2 WATER WELL OWNER: Rolling Meadows Landfill  
RR#, St. Address, Box #: 7351 NW Highway 75 Board of Agriculture, Division of Water Resources  
City, State, ZIP Code: Topeka, KS 66618 Application Number: NA

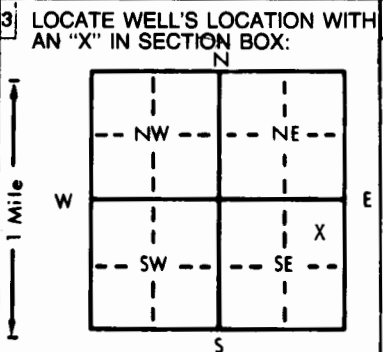

4 DEPTH OF COMPLETED WELL: 24.5 ft. ELEVATION: 991.49  
Depth(s) Groundwater Encountered: 1. NA ft. 2. ft. 3. ft.  
WELL'S STATIC WATER LEVEL: ft. below land surface measured on mo/day/yr  
Pump test data: Well water was ft. after hours pumping gpm  
Est. Yield gpm: Well water was ft. after hours pumping gpm  
Bore Hole Diameter: 6 in. to ft., and in. to ft.  
WELL WATER TO BE USED AS:  
5 Public water supply 8 Air conditioning 11 Injection well  
1 Domestic 3 Feedlot 6 Oil field water supply 9 Dewatering 12 Other (Specify below)  
2 Irrigation 4 Industrial 7 Lawn and garden only 10 Observation well Monitoring Well  
Was a chemical/bacteriological sample submitted to Department? Yes.....No.....; If yes, mo/day/yr sample was submitted  
Water Well Disinfected? Yes No

5 TYPE OF BLANK CASING USED:  
1 Steel 3 RMP (SR) 5 Wrought iron 8 Concrete tile CASING JOINTS: Glued.....Clamped.....  
2 PVC 4 ABS 6 Asbestos-Cement 9 Other (specify below) Welded.....  
7 Fiberglass Threaded.....  
Blank casing diameter: 2 in. to ft., Dia in. to ft., Dia in. to ft.  
Casing height above land surface: 2.5 in., weight lbs./ft. Wall thickness or gauge No. Sch. 40  
TYPE OF SCREEN OR PERFORATION MATERIAL:  
1 Steel 3 Stainless steel 5 Fiberglass 8 RMP (SR) 10 Asbestos-cement  
2 Brass 4 Galvanized steel 6 Concrete tile 9 ABS 11 Other (specify).....  
12 None used (open hole)  
SCREEN OR PERFORATION OPENINGS ARE:  
1 Continuous slot 3 Mill slot 5 Gauzed wrapped 8 Saw cut 11 None (open hole)  
2 Louvered shutter 4 Key punched 6 Wire wrapped 9 Drilled holes  
7 Torch cut 10 Other (specify).....  
SCREEN-PERFORATED INTERVALS: From 24.5 ft. to 14.5 ft., From ft. to ft.  
GRAVEL PACK INTERVALS: From 27.0 ft. to 13.0 ft., From ft. to ft.  
From ft. to ft., From ft. to ft.

6 GROUT MATERIAL: 1 Neat cement 2 Cement grout 3 Bentonite 4 Other Cement/Bentonite  
Grout Intervals: From 75.0 ft. to 27.0 ft., From 10.0 ft. to 0.0 ft., From ft. to ft.  
What is the nearest source of possible contamination:  
1 Septic tank 4 Lateral lines 7 Pit privy 10 Livestock pens 14 Abandoned water well  
2 Sewer lines 5 Cess pool 8 Sewage lagoon 11 Fuel storage 15 Oil well/Gas well  
3 Watertight sewer lines 6 Seepage pit 9 Feedyard 12 Fertilizer storage 16 Other (specify below)  
13 Insecticide storage NA  
Direction from well? How many feet?

FROM	TO	LITHOLOGIC LOG	FROM	TO	LITHOLOGIC LOG
0	2	Limestone, hard, white			
2	57	Shale, dark gray			
57	61	Shale, very soft, light gray			
61	75	Shale, very soft, dark gray-brown claystone			
	73	Light seam			
	75	Bottom of boring			

7 CONTRACTOR'S OR LANDOWNER'S CERTIFICATION: This water well was (1) constructed, (2) reconstructed, or (3) plugged under my jurisdiction and was completed on (mo/day/year) 8/4/90 and this record is true to the best of my knowledge and belief. Kansas Water Well Contractor's License No. 481. This Water Well Record was completed on (mo/day/yr) 5/14/92 under the business name of John Mathes & Associates, Inc. by (signature) Charles W. Roberts

INSTRUCTIONS: Use typewriter or ball point pen. PLEASE PRESS FIRMLY and PRINT clearly. Please fill in blanks, underline or circle the correct answers. Send top three copies to Kansas Department of Health and Environment, Bureau of Water Protection, Topeka, Kansas 66620-7320, Telephone: 913-862-9360. Send one to WATER WELL OWNER and retain one for your records.