


1 LOCATION OF WATER WELL: Fraction $\frac{1}{4}$ $\frac{1}{4}$ SE $\frac{1}{4}$ Section Number 15 Township Number T 10S S Range Number R 15E E/W
 County: Shawnee

Distance and direction from nearest town or city street address of well if located within city?
 8 miles

2 WATER WELL OWNER: Rolling Meadows Landfill
 RR#, St. Address, Box #: 7351 NW Highway 75 Board of Agriculture, Division of Water Resources
 City, State, ZIP Code: Topeka, KS 66618 Application Number: NA

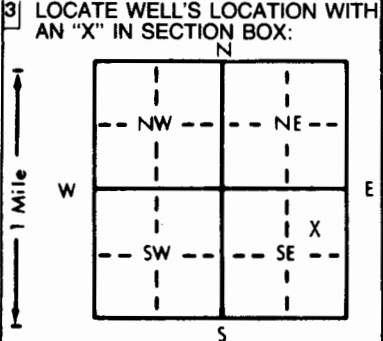

4 DEPTH OF COMPLETED WELL: 53.5 ft. ELEVATION: 1063.0
 Depth(s) Groundwater Encountered 1. ft. 2. ft. 3. ft.
 WELL'S STATIC WATER LEVEL: 47.9 ft. below land surface measured on mo/day/yr 8/9/90
 Pump test data: Well water was ft. after hours pumping gpm
 Est. Yield gpm: Well water was ft. after hours pumping gpm
 Bore Hole Diameter: 6 in. to ft., and in. to ft.
 WELL WATER TO BE USED AS:
 5 Public water supply 8 Air conditioning 11 Injection well
 1 Domestic 3 Feedlot 6 Oil field water supply 9 Dewatering 12 Other (Specify below)
 2 Irrigation 4 Industrial 7 Lawn and garden only 10 Monitoring well Monitoring Well
 Was a chemical/bacteriological sample submitted to Department? Yes No If yes, mo/day/yr sample was submitted
 Water Well Disinfected? Yes No

5 TYPE OF BLANK CASING USED:
 1 Steel 3 RMP (SR) 5 Wrought iron 8 Concrete tile CASING JOINTS: Glued Clamped
 2 PVC 4 ABS 6 Asbestos-Cement 9 Other (specify below) Welded
 7 Fiberglass Threaded
 Blank casing diameter: 2 in. to ft., Dia in. to ft., Dia in. to ft.
 Casing height above land surface: 2.5 in., weight lbs./ft. Wall thickness or gauge No. Sch 40
 TYPE OF SCREEN OR PERFORATION MATERIAL:
 1 Steel 3 Stainless steel 5 Fiberglass 7 PVC 10 Asbestos-cement
 2 Brass 4 Galvanized steel 6 Concrete tile 8 RMP (SR) 11 Other (specify)
 9 ABS 12 None used (open hole)
 SCREEN OR PERFORATION OPENINGS ARE:
 1 Continuous slot 3 Mill slot 5 Gauzed wrapped 8 Saw cut 11 None (open hole)
 2 Louvered shutter 4 Key punched 6 Wire wrapped 9 Drilled holes
 7 Torch cut 10 Other (specify)
 SCREEN-PERFORATED INTERVALS: From 53.5 ft. to 43.3 ft. From ft. to ft.
 From ft. to ft. From ft. to ft.
 GRAVEL PACK INTERVALS: From 53.5 ft. to 42.5 ft. From ft. to ft.
 From ft. to ft. From ft. to ft.

6 GROUT MATERIAL: 1 Neat cement 2 Cement grout 3 Bentonite 4 Other Cement/Bentonite
 Grout Intervals: From 38.5 ft. to 15.0 ft., From 15.0 ft. to 0.0 ft., From ft. to ft.
 What is the nearest source of possible contamination:
 1 Septic tank 4 Lateral lines 7 Pit privy 10 Livestock pens 14 Abandoned water well
 2 Sewer lines 5 Cess pool 8 Sewage lagoon 11 Fuel storage 15 Oil well/Gas well
 3 Watertight sewer lines 6 Seepage pit 9 Feedyard 12 Fertilizer storage 16 Other (specify below)
 13 Insecticide storage NA
 Direction from well? How many feet?

FROM	TO	LITHOLOGIC LOG	FROM	TO	PLUGGING INTERVALS
0	3	Silty clay, dark brown	51.5	53.0	Shale
3	12	Silty clay, light brown	53.0	53.1	Limestone
12	13	Shale, light brown, weathered	53.1	53.5	Shale
13	15	Shale, light gray, soft	53.5	53.5	Bottom of hole
15	33.5	Shale, light gray, soft, weathered			
33.5	36.0	Limestone, gray, hard			
36.0	36.5	Shale			
36.5	36.6	Limestone			
36.6	39.0	Shale			
39.0	41.0	Shale, calcareous, hard			
41.0	41.4	Shale, soft			
41.4	42.5	Shale, hard, calcareous			
42.5	47.0	Limestone, hard, white			
47.0	51.4	Shale, gray, soft			
51.4	51.5	Limestone, hard			

7 CONTRACTOR'S OR LANDOWNER'S CERTIFICATION: This water well was (1) constructed, (2) reconstructed, or (3) plugged under my jurisdiction and was completed on (mo/day/year) 8/6/90 and this record is true to the best of my knowledge and belief. Kansas Water Well Contractor's License No. 481 This Water Well Record was completed on (mo/day/yr) 5/14/92 under the business name of John Mathes & Associates, Inc. by (signature) Charles W. Roberts

INSTRUCTIONS: Use typewriter or ball point pen. PLEASE PRESS FIRMLY and PRINT clearly. Please fill in blanks, underline or circle the correct answers. Send top three copies to Kansas Department of Health and Environment, Bureau of Water, Topeka, Kansas 66620-0001. Telephone: 913-296-5545. Send one to WATER WELL OWNER and retain one for your records.

OFFICE USE ONLY
T
R
EW
SEC
1/4
1/4
1/4