


1 LOCATION OF WATER WELL: County: Shawnee Fraction SW 1/4 NE 1/4 SE 1/4 Section Number 15 Township Number T 10 S Range Number R 15E E/W

Distance and direction from nearest town or city street address of well if located within city? 8 miles

2 WATER WELL OWNER: Rolling Meadows Landfill  
 RR#, St. Address, Box #: 7351 NE Highway 75 Board of Agriculture, Division of Water Resources  
 City, State, ZIP Code: Topeka, KS 66618 Application Number: NA

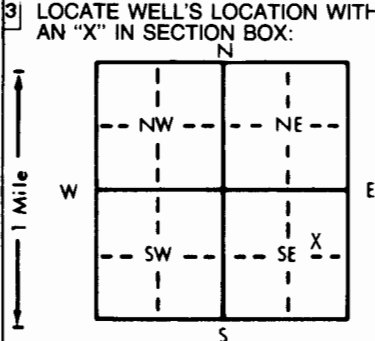

4 DEPTH OF COMPLETED WELL Boring .75 ft. ELEVATION: 997.6  
 Depth(s) Groundwater Encountered 1. ft. 2. ft. 3. ft.  
 WELL'S STATIC WATER LEVEL 0 ft. below land surface measured on mo/day/yr 8/18/92  
 Pump test data: Well water was ft. after hours pumping gpm  
 Est. Yield gpm: Well water was ft. after hours pumping gpm  
 Bore Hole Diameter in. to ft., and in. to ft.  
 WELL WATER TO BE USED AS:  
 5 Public water supply 8 Air conditioning 11 Injection well  
 1 Domestic 3 Feedlot 6 Oil field water supply 9 Dewatering 12 Other (Specify below)  
 2 Irrigation 4 Industrial 7 Lawn and garden only 10 Monitoring well Test Boring  
 Was a chemical/bacteriological sample submitted to Department? Yes No NA; If yes, mo/day/yr sample was submitted  
 Water Well Disinfected? Yes No NA

5 TYPE OF BLANK CASING USED:  
 1 Steel 3 RMP (SR) 5 Wrought iron 8 Concrete tile CASING JOINTS: Glued Clamped  
 2 PVC 4 ABS 6 Asbestos-Cement 9 Other (specify below) Welded  
 7 Fiberglass NONE Threaded  
 Blank casing diameter 8 in. to ft., Dia in. to ft., Dia in. to ft.  
 Casing height at land surface 36 in. weight lbs./ft. Wall thickness or gauge No.  
 TYPE OF SCREEN OR PERFORATION MATERIAL:  
 1 Steel 3 Stainless steel 5 Fiberglass 7 PVC 10 Asbestos-cement  
 2 Brass 4 Galvanized steel 6 Concrete tile 8 RMP (SR) 11 Other (specify) NA  
 9 ABS 12 None used (open hole)  
 SCREEN OR PERFORATION OPENINGS ARE:  
 1 Continuous slot 3 Mill slot 5 Gauzed wrapped 8 Saw cut 11 None (open hole)  
 2 Louvered shutter 4 Key punched 6 Wire wrapped 9 Drilled holes  
 7 Torch cut 10 Other (specify) NA  
 SCREEN-PERFORATED INTERVALS: From ft. to ft. From ft. to ft. From ft. to ft.  
 GRAVEL PACK INTERVALS: From ft. to ft. From ft. to ft. From ft. to ft.

6 GROUT MATERIAL: 1 Neat cement 2 Cement grout 3 Bentonite 4 Other Cement/Bentonite  
 Grout Intervals: From 75' BGS ft. to 0' ft. From ft. to ft. From ft. to ft. From ft. to ft.  
 What is the nearest source of possible contamination:  
 1 Septic tank 4 Lateral lines 7 Pit privy 10 Livestock pens 14 Abandoned water well  
 2 Sewer lines 5 Cess pool 8 Sewage lagoon 11 Fuel storage 15 Oil well/Gas well  
 3 Watertight sewer lines 6 Seepage pit 9 Feedyard 12 Fertilizer storage 16 Other (specify below) NA  
 13 Insecticide storage  
 Direction from well? How many feet?

FROM	TO	LITHOLOGIC LOG	FROM	TO	PLUGGING INTERVALS
0'	5'	Clay			
5'	9'	Soft green shale interbedded with limestone			
9'	11'	Dark gray limestone/fine grained argillaceous			
11'	13'	Green sandstone, fine grained micaceous			
13'	17.5'	Green black shale			
17.5'	22.5'	Dark gray shale			
22.5'	24'	Dark gray limestone, fossiliferous			
24'	29'	dark-gray-black shale			
29'	34'	Dark gray shale with interbedded limestone			
34'	35.5'	Soft black clayey shale			
35.5'	64'	Black shale/siltstone			
64'	65'	Hard yellow limestone			
65'	75'	Dark gray soft shale			

7 CONTRACTOR'S OR LANDOWNER'S CERTIFICATION: This water well was (1) constructed, (2) reconstructed, or (3) plugged under my jurisdiction and was completed on (mo/day/year) 8/18/90 and this record is true to the best of my knowledge and belief. Kansas Water Well Contractor's License No. 481 This Water Well Record was completed on (mo/day/yr) 11/11/92 under the business name of John Mathes & Associates, Inc. by (signature)

INSTRUCTIONS: Use typewriter or ball point pen. PLEASE PRESS FIRMLY and PRINT clearly. Please fill in blanks, underline or circle the correct answers. Send top three copies to Kansas Department of Health and Environment, Bureau of Water, Topeka, Kansas 66620-0001. Telephone: 913-296-5545. Send one to WATER WELL OWNER and retain one for your records.