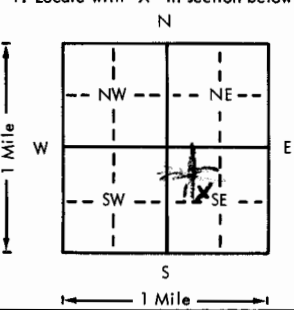
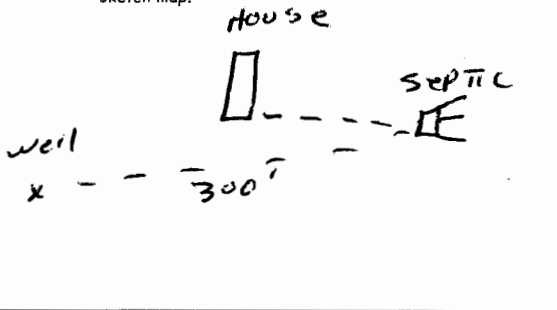


USE TYPEWRITER OR BALL POINT PEN-PRESS FIRMLY, PRINT CLEARLY.

WATER WELL RECORD
KSA 82a-1201-1215

Kansas Department of Health and Environment-Division of Environment
(Water well Contractors)
Topeka, Kansas 66620

DBD

1. Location of well:		County Shawnee	Fraction SE 1/4 NW 1/4 SE 1/4	Section number 35	Township number T 10 S	Range number R 15 E
2. Distance and direction from nearest town or city: 4 NE of 3220 NE, Kincaid Rd Street address of well location if in city: Topeka, KS			3. Owner of well: WILLIAM SCOTT R.R. or street: 3220 NE, Kincaid Rd City, state, zip code: Topeka			
4. Locate with "X" in section below: 			Sketch map: 		6. Bore hole dia. 10 in. Completion date 6-7-77 Well depth 120 ft.	
5. Type and color of material			From	To	7. <input checked="" type="checkbox"/> Cable tool <input checked="" type="checkbox"/> Rotary <input type="checkbox"/> Driven <input type="checkbox"/> Dug <input type="checkbox"/> Hollow rod <input type="checkbox"/> Jetted <input type="checkbox"/> Bored <input type="checkbox"/> Reverse rotary	
					8. Use: <input checked="" type="checkbox"/> Domestic <input type="checkbox"/> Public supply <input type="checkbox"/> Industry <input type="checkbox"/> Irrigation <input type="checkbox"/> Air conditioning <input type="checkbox"/> Stock <input type="checkbox"/> Lawn <input type="checkbox"/> Oil field water <input type="checkbox"/> Other	
					9. Casing: Material PVC Height: Above or below Threaded <input type="checkbox"/> Welded <input type="checkbox"/> Surface 29 in. RMP <input type="checkbox"/> PVC <input checked="" type="checkbox"/> Weight 2.58 lbs./ft. Dia. 5 in. to 120 ft. depth Wall Thickness: inches or Dia. <input type="checkbox"/> in. to <input type="checkbox"/> ft. depth gage No. 2-258	
					10. Screen: Manufacturer's name PUMPCO Type PVC Dia. 5 100 gauze Length 10 Set between 20 ft. and 30 ft. ft. and <input type="checkbox"/> ft. Gravel pack? <input checked="" type="checkbox"/> Size range of material 0.3 to 0.60	
					11. Static water level: <input type="checkbox"/> mo./day/yr. 29 ft. below land surface Date 6-7-77	
					12. Pumping level below land surfaces: ft. after <input type="checkbox"/> hrs. pumping <input type="checkbox"/> g.p.m. ft. after <input type="checkbox"/> hrs. pumping <input type="checkbox"/> g.p.m. Estimated maximum yield 12 g.p.m.	
					13. Water sample submitted: <input type="checkbox"/> mo./day/yr. Yes <input checked="" type="checkbox"/> No Date	
					14. Well head completion: CAP <input type="checkbox"/> Pitless adapter 29 inches above grade	
					15. Well grouted? <input checked="" type="checkbox"/> With: <input type="checkbox"/> Neat cement <input type="checkbox"/> Bentonite <input type="checkbox"/> Concrete Depth: From 0 ft. to 10 ft.	
					16. Nearest source of possible contamination: ft. 300 Direction E Type SEPTIC Well disinfected upon completion? <input checked="" type="checkbox"/> Yes <input type="checkbox"/> No	
					17. Pump: <input checked="" type="checkbox"/> Not installed Manufacturer's name _____ Model number _____ HP _____ Volts _____ Length of drop pipe _____ ft. capacity _____ g.p.m. Type: <input type="checkbox"/> Submersible <input type="checkbox"/> Turbine <input type="checkbox"/> Jet <input type="checkbox"/> Reciprocating <input type="checkbox"/> Centrifugal <input type="checkbox"/> Other	
18. Elevation: 1005			19. Remarks: OWNER TO INSTAL slab		20. Water well contractor's certification: This well was drilled under my jurisdiction and this report is true to the best of my knowledge and belief. Steadie Drilling Co Inc 182 Business name License No. _____ Address RT 1 Holton, KS Signed Dale Peterson Date 6-9-77 Authorized representative	

L 0 L 50 W 35 SE NW SE

Forward the white, blue and pink copies to the Department of Health and Environment

Form WWC-5

BR = 981 ∇ = 976