

WATER WELL RECORD


Form WWC-5

Division of Water Resources App. No.

1 LOCATION OF WATER WELL: County: Shawnee Fraction 1/4 NW 1/4 SE 1/4 NW4 Section Number 31 Township No. T 10 S Range Number R 16 E

Street/Rural Address of Well Location; if unknown, distance & direction from nearest town or intersection: 5210 NW NorthPoint Dr. Topeka, KS Global Positioning System (GPS) information: Latitude: Longitude: Elevation: Datum: Collection Method: Est. Accuracy:

2 WATER WELL OWNER: L.J. Leatherman RR#, Street Address, Box #: 2348 SW Topeka Blvd Topeka, KS. 66611 City, State, ZIP Code

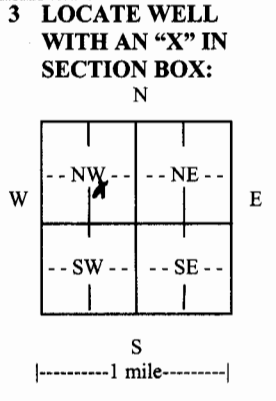

3 LOCATE WELL WITH AN 'X' IN SECTION BOX: 4 DEPTH OF COMPLETED WELL 200 ft. 5-200' Bore 5 Depth(s) Groundwater Encountered (1) None... ft. (2)... ft. (3)... ft. WELL'S STATIC WATER LEVEL None... ft. below land surface measured on mo/day/yr... Pump test data: Well water was... ft. after... hours pumping... gpm EST. YIELD None gpm. Well water was... ft. after... hours pumping... gpm Bore Hole Diameter... in. to... ft., and... in. to... ft. WELL WATER TO BE USED AS: Public water supply, Geothermal, Injection well, Domestic, Feedlot, Oil field water supply, Dewatering, Other (Specify below), Irrigation, Industrial, Domestic-lawn & garden, Monitoring well, Was a chemical/bacteriological sample submitted to Department? Yes No Water well disinfected? Yes No

5 TYPE OF CASING USED: Steel, PVC, Other H.P. Polyethylene CASING JOINTS: Glued, Clamped, Welded, Threaded Casing diameter 3.14 in. to 200 ft., Diameter... in. to... ft., Diameter... in. to... ft. Casing height 36 in., Weight 5.0 lbs./ft., Wall thickness or gauge No. 160.5 TYPE OF SCREEN OR PERFORATION MATERIAL: Steel, Stainless Steel, PVC, Brass, Galvanized Steel, None used (open hole) SCREEN OR PERFORATION OPENINGS ARE: Continuous slot, Mill slot, Gauze wrapped, Torch cut, Drilled holes, None (open hole), Louvered shutter, Key punched, Wire wrapped, Saw cut, Other (specify) SCREEN-PERFORATED INTERVALS: From... ft. to... ft., From... ft. to... ft., From... ft. to... ft. GRAVEL PACK INTERVALS: From... ft. to... ft., From... ft. to... ft., From... ft. to... ft.

6 GROUT MATERIAL: Neat cement, Cement grout, Bentonite, Other Grout Intervals: From 200 ft. to 3 ft., From... ft. to... ft., From... ft. to... ft. What is the nearest source of possible contamination: Septic tank, Lateral lines, Pit privy, Livestock pens, Insecticide storage, Sewer lines, Cesspool, Sewage lagoon, Fuel storage, Abandoned water well, Watertight sewer lines, Seepage pit, Feedyard, Fertilizer storage, Oil well/gas well Direction from well West Distance from well 50

Table with columns: FROM, TO, LITHOLOGIC LOG, FROM, TO, LITHO. LOG (cont.) or PLUGGING INTERVALS. Rows include clay, limestone, shale, and 5-200' Bore 5 plugged with High Solid Bentonite.

7 CONTRACTOR'S OR LANDOWNER'S CERTIFICATION: This water well was constructed, reconstructed, or plugged under my jurisdiction and was completed on (mo/day/year) 6-21-10 and this record is true to the best of my knowledge and belief. Kansas Water Well Contractor's License No. 561 This Water Well Record was completed on (mo/day/year) 6-23-10 under the business name of Evans Energy Dr. Inc. by (signature) [Signature]

INSTRUCTIONS: Use typewriter or ball point pen. PLEASE PRESS FIRMLY and PRINT clearly. Please fill in blanks and check the correct answers. Send three copies (white, blue, pink) to Kansas Department of Health and Environment, Bureau of Water, Geology Section, 1000 SW Jackson St., Suite 420, Topeka, Kansas 66612-1367. Telephone 785-296-5522. Send one copy to WATER WELL OWNER and retain one for your records. Include fee of \$5.00 for each constructed well. Visit us at http://www.kdheks.gov/waterwell/index.html.