

N. Top. Survey Club
2

85

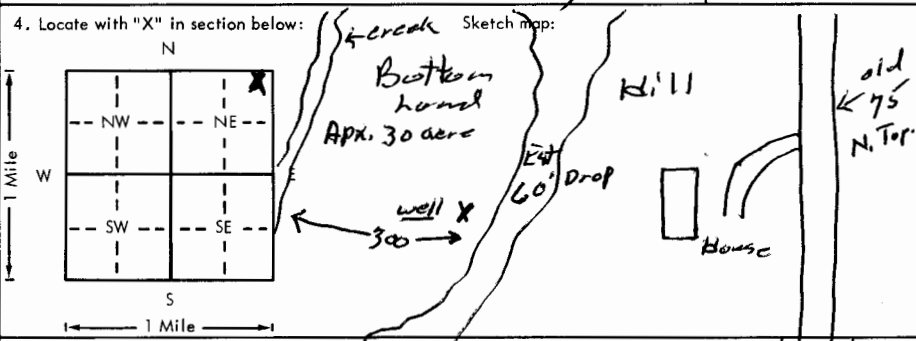
USE TYPEWRITER OR BALL
POINT PEN-PRESS FIRMLY,
PRINT CLEARLY.

WATER WELL RECORD
KSA 82a-1201-1215

AAC

Kansas Department of Health and
Environment-Division of Environment
(Water well Contractors)
Topeka, Kansas 66620

SW

1. Location of well:	County Shawnee	Fraction NE 1/4 NE 1/4 NE 1/4	Section number 18	Township number T 10 S	Range number R 16 E
2. Distance and direction from nearest town or city: 6 N. Topeka		3. Owner of well: Dave MOURN R.R. or street: 3831 S. PARK AVE. City, state, zip code: Topeka, KS. 66601			
4. Locate with "X" in section below: 			6. Bore hole dia. 10 in. Completion date 10-3-78 Well depth 47 ft.		
5. Type and color of material			From	To	7. <input checked="" type="checkbox"/> Cable tool <input checked="" type="checkbox"/> Rotary <input type="checkbox"/> Driven <input type="checkbox"/> Dug <input type="checkbox"/> Hollow rod <input type="checkbox"/> Jetted <input type="checkbox"/> Bored <input type="checkbox"/> Reverse rotary
Top Soil			0	6	8. Use: <input checked="" type="checkbox"/> Domestic <input type="checkbox"/> Public supply <input type="checkbox"/> Industry <input type="checkbox"/> Irrigation <input type="checkbox"/> Air conditioning <input type="checkbox"/> Stock <input type="checkbox"/> Lawn <input type="checkbox"/> Oil field water <input type="checkbox"/> Other
Black Loam			6	16	9. Casing: Material ORC Height Above or below Threaded <input type="checkbox"/> Welded <input type="checkbox"/> Surface 24 in. RMP <input type="checkbox"/> PVC Blue Weight 2.74 lbs./ft. Dia. 5 in. to 47 ft. depth Wall Thickness: inches or Dia. <input type="checkbox"/> in. to <input type="checkbox"/> ft. depth gage No. 1258
Black silt			16	30	10. Screen: Manufacturer's name Pumpco Type PVC Dia. 5" Slot/gauze 020 Length 10' Set between 37 ft. and 47 ft. ft. and <input type="checkbox"/> ft. Gravel pack? yes Size range of material 030/060
Black Fine Sand silty			30	37	11. Static water level: <input type="checkbox"/> mo./day/yr. 30 ft. below land surface Date 10-3-78
Gray Coarse Sand to Pea Gravel			37	44	12. Pumping level below land surfaces: Air Test <input type="checkbox"/> ft. after <input type="checkbox"/> hrs. pumping <input type="checkbox"/> g.p.m. <input type="checkbox"/> ft. after <input type="checkbox"/> hrs. pumping <input type="checkbox"/> g.p.m. Estimated maximum yield 10 g.p.m.
Gray Shale			44	47	13. Water sample submitted: <input type="checkbox"/> Yes <input checked="" type="checkbox"/> No Date <input type="checkbox"/>
					14. Well head completion: Top Cap <input type="checkbox"/> Pitless adapter 24 inches above grade
					15. Well grouted? yes With: <input checked="" type="checkbox"/> Neat cement <input type="checkbox"/> Bentonite <input type="checkbox"/> Concrete Depth: From 0 ft. to 10 ft.
					16. Nearest source of possible contamination: ft. 300 Direction W Type Creek Well disinfected upon completion? <input checked="" type="checkbox"/> Yes <input type="checkbox"/> No
					17. Pump: <input checked="" type="checkbox"/> Not installed Manufacturer's name <input type="checkbox"/> Model number <input type="checkbox"/> HP <input type="checkbox"/> Volts <input type="checkbox"/> Length of drop pipe <input type="checkbox"/> ft. capacity <input type="checkbox"/> g.p.m. Type: <input type="checkbox"/> Submersible <input type="checkbox"/> Turbine <input type="checkbox"/> Jet <input type="checkbox"/> Reciprocating <input type="checkbox"/> Centrifugal <input type="checkbox"/> Other
					20. Water well contractor's certification: This well was drilled under my jurisdiction and this report is true to the best of my knowledge and belief. STRADER DRILLING CO 182 Business name License No. Address RT1 HOLTAN, KS Signed Dave Mourn Date 10-4-78 Authorized representative
18. Elevation: 1030 Topography: <input type="checkbox"/> Hill <input type="checkbox"/> Slope <input type="checkbox"/> Upland <input checked="" type="checkbox"/> Valley	19. Remarks: owner to install slab				

Forward the white, blue and pink copies to the Department of Health and Environment

Form WWC-5

BR = 986

▽ = 1000