

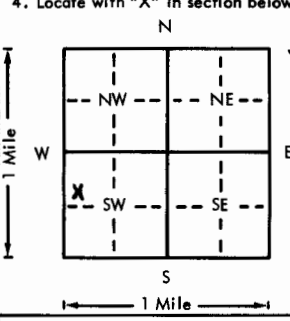
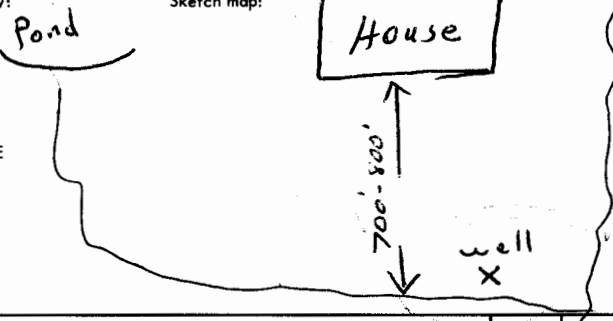
265

USE TYPEWRITER OR BALL POINT PEN-PRESS FIRMLY, PRINT CLEARLY.

WATER WELL RECORD
KSA 82a-1201-1215

Kansas Department of Health and Environment-Division of Environment
(Water well Contractors)
Topeka, Kansas 66620

CBC

| | | | | | | | | | | | |
|---|--|--------------------------------------|--|---|--|---|--|--|--|---|--|
| 1. Location of well: County SHAWNEE | | Fraction SW 1/4 NW 1/4 SW 1/4 | | Section number 33 | | Township number T 10 S R 11 E QW | | Range number | | | |
| 2. Distance and direction from nearest town or city: Street address of well location if in city: 4830 Indian Creek Rd - Topeka | | | | 3. Owner of well: Wanda Kimbrell R.R. or street: 1159 Garfield City, state, zip code: Topeka, Kansas 66601 | | | | | | | |
| 4. Locate with "X" in section below:  | | | | Sketch map:  | | | | 6. Bore hole dia. 8 in. Completion date 8-26-76 Well depth 100 ft. | | 7. <input checked="" type="checkbox"/> Cable tool <input checked="" type="checkbox"/> Rotary <input type="checkbox"/> Driven <input type="checkbox"/> Dug <input type="checkbox"/> Hollow rod <input type="checkbox"/> Jetted <input type="checkbox"/> Bored <input type="checkbox"/> Reverse rotary | |
| 5. Type and color of material | | | | From | | To | | 8. Use: <input checked="" type="checkbox"/> Domestic <input type="checkbox"/> Public supply <input type="checkbox"/> Industry <input type="checkbox"/> Irrigation <input type="checkbox"/> Air conditioning <input type="checkbox"/> Stock <input type="checkbox"/> Lawn <input type="checkbox"/> Oil field water <input type="checkbox"/> Other | | | |
| Sandy Clay - Grey & yellow | | | | 0 | | 19 | | 9. Casing: Material PVC Height: Above or below Threaded <input type="checkbox"/> Welded <input type="checkbox"/> Surface 24 in. RMP <input type="checkbox"/> PVC Glue Weight 2.75 lbs./ft. Dia. 5 in. to 100 ft. depth Wall Thickness: inches or Dia. <input type="checkbox"/> in. to <input type="checkbox"/> ft. depth gage No. 1258 | | | |
| Sand - Gravelly - Dirty | | | | 19 | | 27 | | 10. Screen: Manufacturer's name Pump Co Type PVC Dia. 5" Slot/gauge .025 Length 10' Set between 20' ft. and 30' ft. ft. and <input type="checkbox"/> ft. Gravel pack? <input checked="" type="checkbox"/> Size range of material 0.30-0.80 | | | |
| Intermittent - Limestone + shale strip | | | | 27 | | 100 | | 11. Static water level: <input type="checkbox"/> mo./day/yr. 17.5 ft. below land surface Date 8-26-76 | | | |
| | | | | | | | | 12. Pumping level below land surfaces: Air test <input type="checkbox"/> ft. after <input type="checkbox"/> hrs. pumping <input type="checkbox"/> g.p.m. <input type="checkbox"/> ft. after <input type="checkbox"/> hrs. pumping <input type="checkbox"/> g.p.m. Estimated maximum yield 5 g.p.m. | | | |
| | | | | | | | | 13. Water sample submitted: <input type="checkbox"/> Yes <input checked="" type="checkbox"/> No Date | | | |
| | | | | | | | | 14. Well head completion: Capped Pitless adapter 24 inches above grade | | | |
| | | | | | | | | 15. Well grouted? <input checked="" type="checkbox"/> With: <input checked="" type="checkbox"/> Neat cement <input type="checkbox"/> Bentonite <input type="checkbox"/> Concrete Depth: From 0 ft. to 10 ft. | | | |
| | | | | | | | | 16. Nearest source of possible contamination: ft. 800 Direction S.E. Type L.F.? Lateral Well disinfected upon completion? <input checked="" type="checkbox"/> Yes <input type="checkbox"/> No | | | |
| | | | | | | | | 17. Pump: <input checked="" type="checkbox"/> Not installed Manufacturer's name Model number <input type="checkbox"/> HP <input type="checkbox"/> Volts Length of drop pipe <input type="checkbox"/> ft. capacity <input type="checkbox"/> g.p.m. Type: <input type="checkbox"/> Submersible <input type="checkbox"/> Turbine <input type="checkbox"/> Jet <input type="checkbox"/> Reciprocating <input type="checkbox"/> Centrifugal <input type="checkbox"/> Other | | | |
| | | | | | | | | | | | |
| | | | | | | | | | | | |
| | | | | | | | | | | | |
| 18. Elevation: 956 Topography: <input checked="" type="checkbox"/> Hill <input type="checkbox"/> Slope <input type="checkbox"/> Upland <input checked="" type="checkbox"/> Valley | | 19. Remarks: | | | | | | 20. Water well contractor's certification: This well was drilled under my jurisdiction and this report is true to the best of my knowledge and belief. Strader Dohy Co Inc 182 Business name License No. Address RT 1 Holton, KS Signed Dale Ashburn Date 11-4-76 Authorized representative | | | |

Lateral field
33
SEC
1/4 1/4 1/4 1/4

Forward the white, blue and pink copies to the Department of Health and Environment

Form WWC-5