

USE TYPEWRITER OR BALL POINT PEN-PRESS FIRMLY, PRINT CLEARLY.


WATER WELL RECORD KSA 82a-1201-1215

T R EW sec 1/4 1/4 1/4 No.

Kansas State Dept. Of Health (Water Well Contractors) Forbes-Bldg. 740 Topeka, Kansas 66620

1 Location of well: County Shawnee Township name Fraction N E S W S W Section number 35 Town number T 10 S Range number R 16 E

3 Owner of well: Porterfield, Reed Address: 4706 N.E. Shaffer RD. Topeka

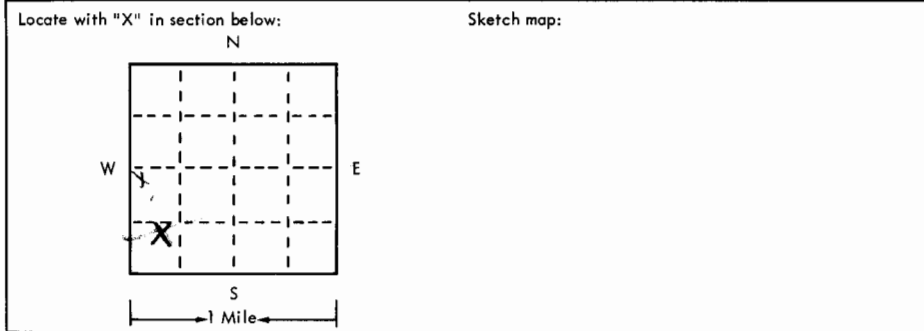

4 Well depth: 65 ft. Date of completion 6/13/75 Well diameter 10 in. 5 Cable tool Rotary Driven Dug Hollow rod Jetted Bored Reverse rotary 6 Use: Domestic Public supply Industry Irrigation Air conditioning Commercial Test well 7 Casing: Material PVC Height: 6 above/below Threaded Welded Surface 17 in. Diam. 5 in Weight lbs./ft. in. to ft. depth Drive shoe? Yes No

Table with 2 columns: Type and color of material, From, To. Rows include Top Soil, Yellow Clay, Yellow Clay with Sand, Coarse Gravel, Blue Lime, White Lime, White Shale, Gray Shale with Lime, Lime Rock, Blue Shale.

8 Screen: Manufacturer Modern Type 200 Dia. 5 in Set/gauze Length 20 Set between 45 ft. and 65 ft. 9 Static water level: 12 ft. below land surface Date 6/13/75 10 Pumping level below land surfaces: Estimated maximum yield 55 g.p.m. Hour 11 Water sample submitted: No Date 12 Well head completion: Pitless adapter Inches above grade 13 Well grouted? Yes No Neat cement Bentonite Depth: From 3 ft. to 13 ft. 14 Nearest source of possible contamination: 225 ft. Direction SW Type Lagoon Well disinfected upon completion? Yes No 15 Pump: Not installed Manufacturer's name Pumpco Model number 102S36 1/3 volts 230 Length of drop pipe 60 ft. capacity 7 g.m.p. Type: Submersible Turbine Jet Reciprocating Centrifugal Other

Silver Lake ? CV

16 Remarks: elevation Slab to be installed by customer 970 Topography: Hill Slope Upland Valley

17 Water well contractor's certification: This well was drilled under my jurisdiction and this report is true to the best of my knowledge and belief. Cummings & Dullis 148 Business name 716 Topeka, KS Address 7/10/75 Date Signed Authorized representative

Forward the white, blue and pink copies to the Kansas State Dept. Of Health.

BR = 955 958