


1 LOCATION OF WATER WELL: Fraction SW 1/4 NW 1/4 SW 1/4 Section Number 35 Township Number T 10 S Range Number R 16 E/W
 County: SHAWNEE

Distance and direction from nearest town or city street address of well if located within city?
5 east, 1 5/8 south of Elmont

2 WATER WELL OWNER: Melvin Eshbaugh
 RR#, St. Address, Box # : 4936 NE Shaffer Rd. Board of Agriculture, Division of Water Resources
 City, State, ZIP Code : Topeka, KS 66617 Application Number:

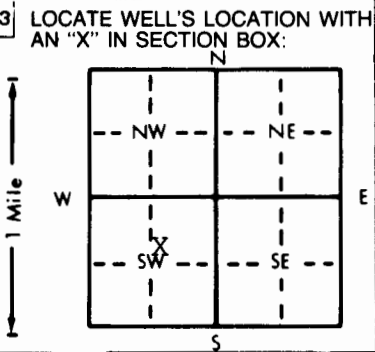

4 DEPTH OF COMPLETED WELL: 108 ft. ELEVATION: ft.
 Depth(s) Groundwater Encountered 1. 17' ft. 2. ft. 3. ft.
 WELL'S STATIC WATER LEVEL 14' ft. below land surface measured on mo/day/yr 7-11-91
 Pump test data: Well water was ft. after hours pumping gpm
 Est. Yield 1 1/2 gpm: Well water was ft. after hours pumping gpm
 Bore Hole Diameter: 8 3/4 in. to ft., and in. to ft.
 WELL WATER TO BE USED AS: 5 Public water supply 8 Air conditioning 11 Injection well
1 Domestic 3 Feedlot 6 Oil field water supply 9 Dewatering 12 Other (Specify below)
2 Irrigation 4 Industrial 7 Lawn and garden only 10 Monitoring well
 Was a chemical/bacteriological sample submitted to Department? Yes.....No...X.....; If yes, mo/day/yr sample was submitted
 Water Well Disinfected? Yes X No

5 TYPE OF BLANK CASING USED: 5 Wrought iron 8 Concrete tile CASING JOINTS: Glued X Clamped
 1 Steel 3 RMP (SR) 6 Asbestos-Cement 9 Other (specify below) Welded
 2 PVC 4 ABS 7 Fiberglass Threaded.....
 Blank casing diameter 5" in. to 0-17 ft., Dia 5" in. to 27-108 ft., Dia in. to ft.
 Casing height above land surface 24" in., weight 2.82 lbs./ft. Wall thickness or gauge No. .258
 TYPE OF SCREEN OR PERFORATION MATERIAL: 7 PVC 10 Asbestos-cement
 1 Steel 3 Stainless steel 5 Fiberglass 8 RMP (SR) 11 Other (specify)
 2 Brass 4 Galvanized steel 6 Concrete tile 9 ABS 12 None used (open hole)
 SCREEN OR PERFORATION OPENINGS ARE: 5 Gauzed wrapped 8 Saw cut 11 None (open hole)
 1 Continuous slot 3 Mill slot 6 Wire wrapped 9 Drilled holes
 2 Louvered shutter 4 Key punched 7 Torch cut 10 Other (specify)
 SCREEN-PERFORATED INTERVALS: From 17 ft. to 27 ft., From ft. to ft.
 From 107 ft. to 108 ft., From ft. to ft.
 GRAVEL PACK INTERVALS: From 14 ft. to 108 ft., From ft. to ft.
 From ft. to ft., From ft. to ft.

6 GROUT MATERIAL: 1 Neat cement 2 Cement grout 3 Bentonite 4 Other hole plug.....
 Grout Intervals: From 0 ft. to 14 ft., From ft. to ft., From ft. to ft.
 What is the nearest source of possible contamination: 10 Livestock pens 14 Abandoned water well
 1 Septic tank 4 Lateral lines 7 Pit privy 11 Fuel storage 15 Oil well/Gas well
 2 Sewer lines 5 Cess pool 8 Sewage lagoon 12 Fertilizer storage 16 Other (specify below)
 3 Watertight sewer lines 6 Seepage pit 9 Feedyard 13 Insecticide storage
 Direction from well? west How many feet? 142'

FROM	TO	LITHOLOGIC LOG	FROM	TO	PLUGGING INTERVALS
0	4	Top Soil			
4	17	Clay-Brown			7-18-91 Received permission to shallow grout from Don Taylor
17	18	Cherty Limestone-Loose			
18	24	Shale-Tan			
24	32	Shale-Grey			
32	37	Limestone-Grey			
37	38	Shale-Black			
38	42	Limestone-Grey			
42	44	Shale-Grey			
44	48	Limestone-Grey			
48	49	Shale-Grey			
49	51	Limestone-Grey			
57	59	Shale-Grey			
59	64	Limestone-Grey			

7 CONTRACTOR'S OR LANDOWNER'S CERTIFICATION: This water well was (1) constructed, (2) reconstructed, or (3) plugged under my jurisdiction and was completed on (mo/day/year) 7-11-91 and this record is true to the best of my knowledge and belief. Kansas Water Well Contractor's License No. 182 This Water Well Record was completed on (mo/day/yr) 8-12-91 under the business name of STRADER DRILLING CO., INC. by (signature) Wall Baker

INSTRUCTIONS: Use typewriter or ball point pen. PLEASE PRESS FIRMLY and PRINT clearly. Please fill in blanks, underline or circle the correct answers. Send top three copies to Kansas Department of Health and Environment, Bureau of Water, Topeka, Kansas 66620-7320. Telephone: 913-296-5545. Send one to WATER WELL OWNER and retain one for your records.

OFFICE USE ONLY