

ZJ 10-20-5
checked MHZ

✓BAT

USE TYPEWRITER OR BALL POINT PEN-PRESS FIRMLY, PRINT CLEARLY.

Phone # 484-2306


WATER WELL RECORD
KSA 82a-1201-1215

T R EW sec 1/4 1/4 1/4 No.

Kansas State Dept. Of Health
(Water Well Contractors)
Forbes-Bldg. 740
Topeka, Kansas 66620

1 Location of well: County Jeff Township name Rock Creek Fraction NE 1/4 Section number 3 Town number 10 Range number 17E

Distance and direction from nearest town or city: 3 1/2 mile NE of Meriden. 3 Owner of well: Russell Northrup
Street address of well location if in city: Meriden, Kans. Address: RT 2 Meriden, Kans.

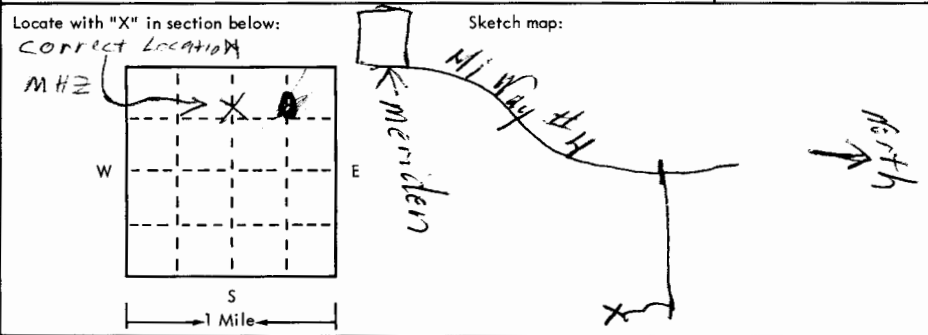

4 Well depth: 81 ft. Date of completion Oct 19, 15
Well diameter 6 in.

5 Cable tool Rotary Driven Dug
 Hollow rod Jetted Bored Reverse rotary

6 Use: Domestic Public supply Industry
 Irrigation Air conditioning Commercial
 Test well

7 Casing: Material Styrene Height: above/below
Threaded Welded Surface 24 in.
Diam. 5 in. to 81 ft. depth Drive shoe? Yes No
5 in. to 81 ft. depth

2	Type and color of material	From	To
	Glacial Till - Yellow	0	28
	Shale grey	28	31
	lime dark grey	31	35
	shale grey	35	39
	lime grey	39	46
	shale grey	46	49
	lime grey	49	60
	shale grey	60	81

8 Screen: Field
Manufacturer Styrene Dia. 5
Type Styrene Dia. 5
Slot/gauze 3/16 Length 16
Set between 16 ft. and 81 ft.
Fittings:
Gravel pack Yes No Size range of material

9 Static water level:
32 ft. below land surface Date Oct 19, 15

10 Pumping level below land surfaces:
 ft. after hrs. pumping g.p.m.
 ft. after hrs. pumping g.p.m.
Estimated maximum yield 1.2 g.p.m.

11 Water sample submitted:
 Yes No Date

12 Well head completion:
 Pitless adapter Inches above grade

13 Well grouted? Yes No
 Neat cement Bentonite
Depth: From 0 ft. to 13 ft.

14 Nearest source of possible contamination:
ft. 130 Direction West Type Septic Tank
Well disinfected upon completion? Yes No

15 Pump: Not installed
Manufacturer's name
Model number HP Volts
Length of drop pipe ft. capacity g.m.p.
Type:
 Submersible Turbine
 Jet Reciprocating
 Centrifugal Other

16 Remarks: elevation 1012 ft
m 42
Topography:
 Hill
 Slope
 Upland
 Valley

Owner to install slab-RN

17 Water well contractor's certification:
This well was drilled under my jurisdiction and this report is true to the best of my knowledge and belief.
Robison Well Drilling
Business name 316A License No.
Address Carbondale, KS.
Signed Frank H. Nelson Date Oct 19, 15
Authorized representative

Forward the white, blue and pink copies to the Kansas State Dept. Of Health.
NOTE: well is about 50 ft South east of house on Topo and is at same elevation correct Legal Description is SW 1/4 NW 1/4 NE 1/4 Sect 3, T10S R17E
BR = 984 10 = 990

10 17 E 3 SW NE NE