


1 LOCATION OF WATER WELL: Fraction SE 1/4 SE 1/4 NW 1/4 Section Number 3 Township Number T 10 S Range Number R 17 E  
 County: Jefferson

Distance and direction from nearest town or city street address of well if located within city? 2 1/2 E 2 N of Meriden

2 WATER WELL OWNER: Jefferson Co RWD #3 Well #4  
 RR#, St. Address, Box #: Rt 2 Tottaran Huskey Board of Agriculture, Division of Water Resources  
 City, State, ZIP Code: Meriden, KS 66512 Application Number:

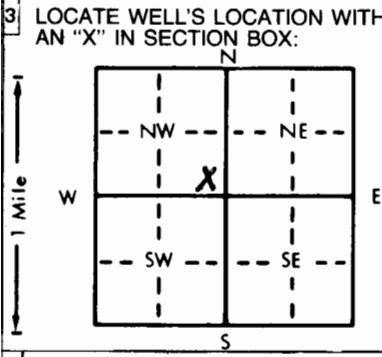

4 DEPTH OF COMPLETED WELL: 82 ft. ELEVATION: .....  
 Depth(s) Groundwater Encountered 1. 26 ft. 2. .... ft. 3. .... ft.  
 WELL'S STATIC WATER LEVEL: 9 ft. below land surface measured on mo/day/yr 9-6-85  
 Pump test data: Well water was ..... ft. after ..... hours pumping ..... gpm  
 Est. Yield: 500 gpm; Well water was ..... ft. after ..... hours pumping ..... gpm  
 Bore Hole Diameter: 10 in. to ..... ft., and ..... in. to ..... ft.  
 WELL WATER TO BE USED AS:  
 5 Public water supply 8 Air conditioning 11 Injection well  
 1 Domestic 3 Feedlot 6 Oil field water supply 9 Dewatering 12 Other (Specify below)  
 2 Irrigation 4 Industrial 7 Lawn and garden only 10 Observation well  
 Was a chemical/bacteriological sample submitted to Department? Yes  No .....; If yes, mo/day/yr sample was submitted 9-12-85 Water Well Disinfected? Yes  No

5 TYPE OF BLANK CASING USED:  
 1 Steel 3 RMP (SR) 5 Wrought iron 8 Concrete tile CASING JOINTS: Glued ..... Clamped .....  
 2 PVC 4 ABS 6 Asbestos-Cement 9 Other (specify below) Welded   
 7 Fiberglass ..... Threaded.....  
 Blank casing diameter: 12 in. to 0.62 ft., Dia ..... in. to ..... ft., Dia ..... in. to ..... ft.  
 Casing height above land surface: 36 in., weight 49.56 lbs./ft. Wall thickness or gauge No. 375

TYPE OF SCREEN OR PERFORATION MATERIAL:  
 1 Steel 3 Stainless steel 5 Fiberglass 7 PVC 10 Asbestos-cement  
 2 Brass 4 Galvanized steel 6 Concrete tile 8 RMP (SR) 11 Other (specify) .....  
 9 ABS 12 None used (open hole)

SCREEN OR PERFORATION OPENINGS ARE:  
 1 Continuous slot 3 Mill slot 5 Gauzed wrapped 8 Saw cut 11 None (open hole)  
 2 Louvered shutter 4 Key punched 6 Wire wrapped 9 Drilled holes  
 7 Torch cut 10 Other (specify) Johnson .080

SCREEN-PERFORATED INTERVALS: From 62 ft. to 82 ft., From ..... ft. to ..... ft.  
 From ..... ft. to ..... ft., From ..... ft. to ..... ft.  
 GRAVEL PACK INTERVALS: From 25 ft. to 82 ft., From ..... ft. to ..... ft.  
 From ..... ft. to ..... ft., From ..... ft. to ..... ft.

6 GROUT MATERIAL: 1 Neat cement 2 Cement grout 3 Bentonite 4 Other .....  
 Grout Intervals: From 0 ft. to 25 ft., From ..... ft. to ..... ft., From ..... ft. to ..... ft.

What is the nearest source of possible contamination:  
 1 Septic tank 4 Lateral lines 7 Pit privy 10 Livestock pens 14 Abandoned water well  
 2 Sewer lines 5 Cess pool 8 Sewage lagoon 11 Fuel storage 15 Oil well/Gas well  
 3 Watertight sewer lines 6 Seepage pit 9 Feedyard 12 Fertilizer storage 16 Other (specify below)  
 13 Insecticide storage .....  
 Direction from well? N How many feet? 3,000

FROM	TO	LITHOLOGIC LOG	FROM	TO	LITHOLOGIC LOG
0	6	Top soil			
6	16	Clay, brown			
16	26	Clay, blue			
26	35	Chert 1/4x1/2 FS, CS			
35	41	FS, brown			
41	47	FS, CS, Med gravel			
47	67	Chert 1/4x1/2 FS, CS, Med-cemented-Boulders			
67	72	FS, CS, Med, Pea 1/2x1/4 not cemented			
72	82	FS, CS, Med-gravel			
82	100	FS, CS, Brown			

7 CONTRACTOR'S OR LANDOWNER'S CERTIFICATION: This water well was (1) constructed, (2) reconstructed, or (3) plugged under my jurisdiction and was completed on (mo/day/year) 9-6-85 and this record is true to the best of my knowledge and belief. Kansas Water Well Contractor's License No. 182 This Water Well Record was completed on (mo/day/yr) 9-26-85 under the business name of Strader Drilling Co Inc by (signature) Dale Astoren

INSTRUCTIONS: Use typewriter or ball point pen, PLEASE PRESS FIRMLY and PRINT clearly. Please fill in blanks, underline or circle the correct answers. Send top three copies to Kansas Department of Health and Environment, Division of Environment, Environmental Geology Section, Topeka, KS 66620. Send one to WATER WELL OWNER and retain one for your records.