

USE TYPEWRITER OR BALL POINT PEN-PRESS FIRMLY, PRINT CLEARLY.


abb

WATER WELL RECORD
KSA 82a-1201-1215

Kansas Department of Health and Environment-Division of Environment
(Water well Contractors)
Topeka, Kansas 66620

1. Location of well: County Jefferson Fraction NE 1/4 NE 1/4 NW 1/4 Section number 10 Township number T 10 S R 17 Range number EW

2. Distance and direction from nearest town or city: _____
Street address of well location if in city: _____
3. Owner of well: Stiles Robert
R.R. or street: R. R. 2
City, state, zip code: Meriden Ks. 66512

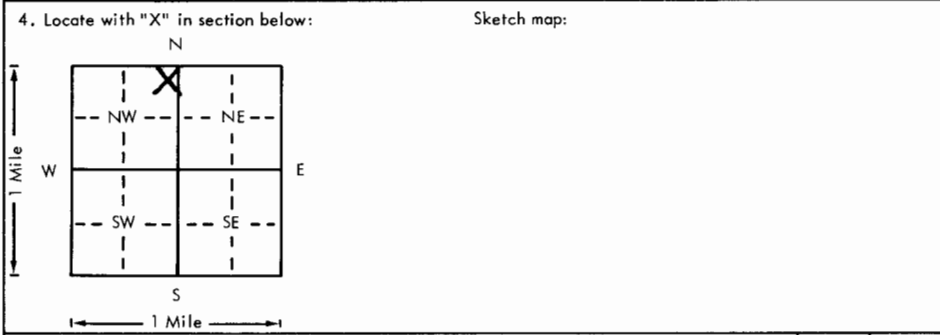

6. Bore hole dia. 10 in. Completion date 10/21/76
Well depth 80 ft.
7. Cable tool Rotary Driven Dug
 Hollow rod Jetted Bored Reverse rotary
8. Use: Domestic Public supply Industry
 Irrigation Air conditioning Stock
 Lawn Oil field water Other
9. Casing: Material PVC Height: Above or below
Threaded Welded Surface 206 in.
RMP PVC Weight 200 lbs./ft.
Dia. 5 in. to 38 ft. depth Wall Thickness: inches or
Dia. 49 in. to 57 ft. depth gage No. Sch 40 ABC

5. Type and color of material	From	To
Top soil	0	2
Brown Clay with F sand	2	8
Yellow Clay with F sand	8	12
Yellow Clay with C sand	12	16
Coarse sand and Gravel	16	22
White Lime Rock	22	30
Gray sand shale	30	55
Sand with Yellow Lime Gravel	55	59
Gray shale	59	80

10. Screen: Manufacturer's name Morden Pipe
Type PVC Dia. 5 in.
Slot gauze 1/4 Length 30
Set between 38 ft. and 48 ft.
60 ft. and 80 ft.
Gravel pack? Yes size range of material 1/2
11. Static water level: _____ mo./day/yr.
26 ft. below land surface Date 10/21/76
12. Pumping level below land surfaces:
_____ ft. after _____ hrs. pumping _____ g.p.m.
_____ ft. after _____ hrs. pumping _____ g.p.m.
Estimated maximum yield _____ g.p.m.
13. Water sample submitted: _____ mo./day/yr.
Yes No Date _____
14. Well head completion:
_____ Pitless adapter _____ Inches above grade
15. Well grouted? Yes
With: Neat cement Bentonite Concrete
Depth: From 3 ft. to 13 ft.
16. Nearest source of possible contamination:
ft. 90 Direction South Septic
Well disinfected upon completion? Yes Yes No

18. Elevation: _____
19. Remarks: Concrete slab instsled by customer
Topography:
 Hill
 Slope
 Upland
 Valley

20. Water well contractor's certification:
This well was drilled under my jurisdiction and this report is true to the best of my knowledge and belief.
Cummings Drilling Co 148
Business name _____ License No. _____
Address R R 10 Topeka
Signed Frederic Cummings Date 11/15/76
Authorized Representative

T
R
Sec
10
17
10
NE
NE
NW