


1 LOCATION OF WATER WELL: Fraction SW 1/4 NW 1/4 NE 1/4 Section Number 19 Township Number T 10 S Range Number R 17 E/W
 County: JEFFERSON

Distance and direction from nearest town or city street address of well if located within city?
 1/2 mile east of Newman

2 WATER WELL OWNER: Charles Hladky
 RR#, St. Address, Box #: Rt. 1 Box 43 Board of Agriculture, Division of Water Resources
 City, State, ZIP Code: Perry, KS 66073 Application Number:

3 LOCATE WELL'S LOCATION WITH AN "X" IN SECTION BOX:

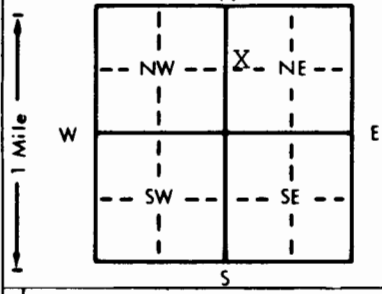

4 DEPTH OF COMPLETED WELL... 52' ft. ELEVATION:
 Depth(s) Groundwater Encountered 1. ft. 2. ft. 3. ft.
 WELL'S STATIC WATER LEVEL ... 23' ft. below land surface measured on mo/day/yr 3-16-92
 Pump test data: Well water was ft. after hours pumping gpm
 Est. Yield ... 50 ... gpm: Well water was ft. after hours pumping gpm
 Bore Hole Diameter ... 12" in. to ft., and in. to ft.
 WELL WATER TO BE USED AS: 5 Public water supply 8 Air conditioning 11 Injection well
 1 Domestic 3 Feedlot 6 Oil field water supply 9 Dewatering 12 Other (Specify below)
 2 Irrigation 4 Industrial 7 Lawn and garden only 10 Monitoring well
 Was a chemical/bacteriological sample submitted to Department? Yes.....No...X...; If yes, mo/day/yr sample was submitted
 Water Well Disinfected? Yes X No

5 TYPE OF BLANK CASING USED: 5 Wrought iron 8 Concrete tile CASING JOINTS: Glued X Clamped
 1 Steel 3 RMP (SR) 6 Asbestos-Cement 9 Other (specify below) Welded
 2 PVC 4 ABS 7 Fiberglass Threaded

Blank casing diameter ... 5" in. to .0-40 ft., Dia ... in. to ... ft., Dia ... in. to ... ft.
 Casing height above land surface ... 24" in., weight ... 2.82 lbs./ft. Wall thickness or gauge No. ... 258

TYPE OF SCREEN OR PERFORATION MATERIAL: 7 PVC 10 Asbestos-cement
 1 Steel 3 Stainless steel 5 Fiberglass 8 RMP (SR) 11 Other (specify)
 2 Brass 4 Galvanized steel 6 Concrete tile 9 ABS 12 None used (open hole)

SCREEN OR PERFORATION OPENINGS ARE: 5 Gauzed wrapped 8 Saw cut 11 None (open hole)
 1 Continuous slot 3 Mill slot 6 Wire wrapped 9 Drilled holes
 2 Louvered shutter 4 Key punched 7 Torch cut 10 Other (specify)

SCREEN-PERFORATED INTERVALS: From ... 40 ... ft. to ... 52 ... ft., From ... ft. to ... ft.
 GRAVEL PACK INTERVALS: From ... 24 ... ft. to ... 52 ... ft., From ... ft. to ... ft.

6 GROUT MATERIAL: 1 Neat cement 2 Cement grout 3 Bentonite 4 Other
 Grout Intervals: From ... 4 ... ft. to ... 24 ... ft., From ... ft. to ... ft., From ... ft. to ... ft.

What is the nearest source of possible contamination: 10 Livestock pens 14 Abandoned water well
 1 Septic tank 4 Lateral lines 7 Pit privy 11 Fuel storage 15 Oil well/Gas well
 2 Sewer lines 5 Cess pool 8 Sewage lagoon 12 Fertilizer storage 16 Other (specify below)
 3 Watertight sewer lines 6 Seepage pit 9 Feedyard 13 Insecticide storage

Direction from well? east How many feet? 95'

FROM	TO	LITHOLOGIC LOG	FROM	TO	PLUGGING INTERVALS
0	6	Top Soil			
6	30	Clay-Brown-Sandy			
30	35	Fine Sand-Brown			
35	45	Fine Sand-Coarse Sand-Brown			
45	47	Clay-Blue			
47	52	Fine Sand-Coarse Sand-Med-Pea Gravel, Brown			

7 CONTRACTOR'S OR LANDOWNER'S CERTIFICATION: This water well was (1) constructed, (2) reconstructed, or (3) plugged under my jurisdiction and was completed on (mo/day/year) ... 3-16-92 ... and this record is true to the best of my knowledge and belief. Kansas Water Well Contractor's License No. ... 182 ... This Water Well Record was completed on (mo/day/yr) 4-7-92 under the business name of STRADER DRILLING CO., INC. by (signature) Dale Skoren