


1 LOCATION OF WATER WELL: Fraction NE 1/4 NW 1/4 SW 1/4 Section Number 24 Township Number T 10S S Range Number R 17E E/W
 County: JEFFERSON

Distance and direction from nearest town or city street address of well if located within city?
 5 east, 1 1/2 south of Meriden

2 WATER WELL OWNER: Ron Boggs
 RR#, St. Address, Box #: 3711 S.W. Park S. Apt. 3 heat pump holes Board of Agriculture, Division of Water Resources
 City, State, ZIP Code: Topeka, KS 66609 Application Number:

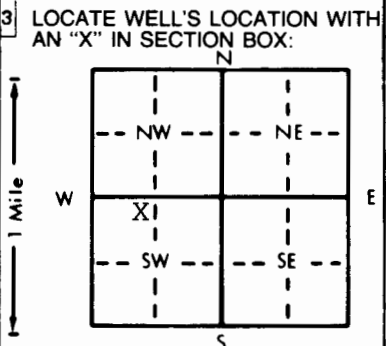

4 DEPTH OF COMPLETED WELL... 138! ft. ELEVATION: ...
 Depth(s) Groundwater Encountered 999 ft. 2. ft. 3. ft.
 WELL'S STATIC WATER LEVEL 999 ft. below land surface measured on mo/day/yr
 Pump test data: Well water was ... ft. after ... hours pumping ... gpm
 Est. Yield ... gpm: Well water was ... ft. after ... hours pumping ... gpm
 Bore Hole Diameter... 6" in. to ... ft., and ... in. to ... ft.
 WELL WATER TO BE USED AS:
 5 Public water supply 8 Air conditioning 11 Injection well
 1 Domestic 3 Feedlot 6 Oil field water supply 9 Dewatering ② Other (Specify below)
 2 Irrigation 4 Industrial 7 Lawn and garden only 10 Monitoring well heat pump
 Was a chemical/bacteriological sample submitted to Department? Yes... No... If yes, mo/day/yr sample was submitted
 Water Well Disinfected? Yes X No

5 TYPE OF BLANK CASING USED:
 1 Steel 3 RMP (SR) 5 Wrought iron 8 Concrete tile CASING JOINTS: Glued ... Clamped ...
 2 PVC 4 ABS 6 Asbestos-Cement 9 Other (specify below) Welded ...
 7 Fiberglass Plastic Threaded ...
 Blank casing diameter 2 1/4 in. to ... ft., Dia ... in. to ... ft., Dia ... in. to ... ft.
 Casing height at land surface 36 in., weight ... lbs./ft. Wall thickness or gauge No. ...
 TYPE OF SCREEN OR PERFORATION MATERIAL:
 1 Steel 3 Stainless steel 5 Fiberglass 8 RMP (SR) 10 Asbestos-cement 11 Other (specify) NA
 2 Brass 4 Galvanized steel 6 Concrete tile 9 ABS 12 None used (open hole)
 SCREEN OR PERFORATION OPENINGS ARE:
 1 Continuous slot 3 Mill slot 5 Gauzed wrapped 8 Saw cut 11 None (open hole)
 2 Louvered shutter 4 Key punched NA 6 Wire wrapped 9 Drilled holes NA
 7 Torch cut
 SCREEN-PERFORATED INTERVALS: From ... ft. to ... ft., From ... ft. to ... ft., From ... ft. to ... ft.
 GRAVEL PACK INTERVALS: From ... ft. to ... ft., From ... ft. to ... ft., From ... ft. to ... ft.

6 GROUT MATERIAL: 1 Neat cement 2 Cement grout 3 Bentonite 4 Other ...
 Grout Intervals: From ... 0 ft. to ... 138 ft., From ... ft. to ... ft., From ... ft. to ... ft.
 What is the nearest source of possible contamination:
 1 Septic tank 4 Lateral lines 7 Pit privy 10 Livestock pens 14 Abandoned water well
 2 Sewer lines 5 Cess pool 8 Sewage lagoon 11 Fuel storage 15 Oil well/Gas well
 3 Watertight sewer lines 6 Seepage pit 9 Feedyard 12 Fertilizer storage 16 Other (specify below)
 13 Insecticide storage
 Direction from well? How many feet?

FROM	TO	LITHOLOGIC LOG	FROM	TO	PLUGGING INTERVALS
0	3	Clay-Brown			
3	13	Limestone-Yellow			
13	35	Shale-Grey			
35	37	Sandstone-Brown			
37	52	Shale-Grey			
52	70	Limestone-Grey			
70	73	Shale-Black			
73	76	Limestone-Grey			
76	79	Shale-Grey			
79	85	Limestone-Grey			
85	138	Shale-Grey			

7 CONTRACTOR'S OR LANDOWNER'S CERTIFICATION: This water well was (1) constructed, (2) reconstructed, or (3) plugged under my jurisdiction and was completed on (mo/day/year) 7-16-93 and this record is true to the best of my knowledge and belief. Kansas Water Well Contractor's License No. 182 This Water Well Record was completed on (mo/day/yr) 8-23-93 under the business name of STRADER DRILLING CO., INC. by (signature) [Signature]

INSTRUCTIONS: Use typewriter or ball point pen. PLEASE PRESS FIRMLY and PRINT clearly. Please fill in blanks, underline or circle the correct answers. Send top three copies to Kansas Department of Health and Environment, Bureau of Water, Topeka, Kansas 66620-0001. Telephone: 913-296-5545. Send one to WATER WELL OWNER and retain one for your records.