

County: Jefferson Fraction: NE SE NE Sec. 3 T 10 S R 17 E

CORRECTION(S) TO WATER WELL COMPLETION RECORD (WWC-5) - to rectify lacking or incorrect information

Owner: Wittmer Farm Realty

If corrected, location was listed as:

Section-Township-Range: 3-10-17

Fraction (1/4 1/4 1/4): several

Location changed to:

3-10 S-17 E

NE SE NE

Other changes: Initial statements: _____

Changed to: _____

Comments: _____

Verification method: written & legal descriptions, sketch map on form, note at bottom of form about being parcel just north of Pierson's, Jefferson County online parcel search, mapping tool on KGS website. Initials: DPB Date: 12/12/2017

Submitted by: Kansas Geological Survey, Data Resources Library, 1930 Constant Avenue, Lawrence, KS 66047-3724

Kansas Dept. of Health & Environment, Bureau of Water, 1000 SW Jackson, Suite 420, Topeka, KS 66612-1367

ZJ-10-80-4
 checked but need confirmation
 by phone (?) M12

USE TYPEWRITER OR BALL
 POINT PEN-PRESS FIRMLY,
 PRINT CLEARLY.

check map
 OK
 Hope map
 29
 S/2 SE NE


WATER WELL RECORD
 KSA 82a-1201-1215

R EW sec 1/4 1/4 1/4 Jo.

Kansas State Dept. Of Health
 (Water Well Contractors)
 Forbes-Bldg. 740
 Topeka, Kansas 66620

1 Location of well: County Jefferson Township name Rock Creek Fraction S 1/4 Section number 3 Town number 10 Range number 17

Distance and direction from nearest town or city: 1 1/2 W - 1/4 S
 Street address of well location if in city: New Ozarkie, KS
 3 Owner of well: WITMER FARM REALTY
 Address: 1136 S.W. WANAMAKOE RD, TOPEKA KANSAS

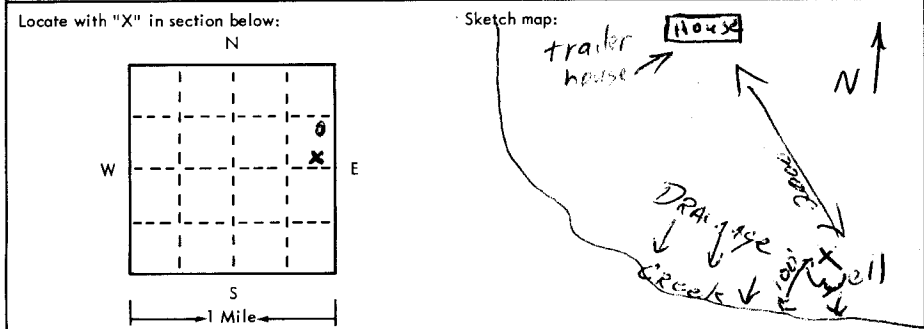

4 Well depth: 60 ft. Date of completion 12-17-75
 Well diameter 8 in.

5 Cable tool Rotary Driven Dug
 Hollow rod Jetted Bored Reverse rotary

6 Use: Domestic Public supply Industry
 Irrigation Air conditioning Commercial
 Test well

7 Casing: Material PVC Height: above/below
 Threaded Welded Surface 24 in.
 Diam. 5 in. to 60 ft. depth Weight 233 lbs./ft.
 Drive shoe? Yes No

2	Type and color of material	From	To
	Top Soil	0	6
	Grey Clay - sandy	6	17
	Coarse sand - Gravelly	17	19
	Grey Shale	19	23
	Grey Sand Stone	23	26
	Grey Limestone	26	30
	Blue Shale	30	31
	Grey Limestone	31	34
	Grey Shale	34	37
	White Limestone	37	44
	Grey Shale	44	56
	Grey Limestone	56	58
	Grey Shale	57	60

8 Screen:
 Manufacturer Pumpco
 Type PVC Dia. 5"
 Slot 1080 Length 30
 Set between 20 ft. and 20 ft.
 Fittings:
 Gravel pack Yes No Size range of material 4x8

9 Static water level:
8 ft. below land surface Date 12-14-75

10 Pumping level below land surfaces: PIR TEST
 ___ ft. after ___ hrs. pumping ___ g.p.m.
 ___ ft. after ___ hrs. pumping ___ g.p.m.
 Estimated maximum yield 7 g.p.m.

11 Water sample submitted:
 Yes No Date ___

12 Well head completion: Capped
 Pitless adapter Inches above grade

13 Well grouted? Yes No
 Neat cement Bentonite
 Depth: From 0 ft. to 10 ft.

14 Nearest source of possible contamination: 800
 ft 2002 Direction N Type yard
 Well disinfected upon completion? Yes No

15 Pump: Not installed
 Manufacturer's name _____
 Model number _____ HP _____ Volts _____
 Length of drop pipe _____ ft. capacity _____ g.m.p.
 Type:
 Submersible Turbine
 Jet Reciprocating
 Centrifugal Other

16 Remarks: elevation 932 ft
 M12
 Topography: NOTE: No one here to confirm ownership by Witmer
 Hill Form Realty. Mail box says a family Pierson.
 Slope Although names don't match, location & map & well descrip
 Upland seem to match. You can see the well from the highway.
 Valley M12

17 Water well contractor's certification:
 This well was drilled under my jurisdiction and this report is true to the best of my knowledge and belief.
Strader Dalg Co Inc 182
 Business name License No.
 Address 211 HOLTAN, KS
 Signed Dele Crutcher Date 12-23-75
 Authorized representative

Forward the white, blue and pink copies to the Kansas State Dept. Of Health.

Form WWC-5

↳ Pierson says it's not their well but know to the north.
 BR = 913
 V = 124

10
 17E
 3
 S/2 SE NE
 35