


1 LOCATION OF WATER WELL: Fraction SW 1/4 NW 1/4 NE 1/4 Section Number 1 Township Number T 10 S Range Number R 18 EW

Distance and direction from nearest town or city street address of well if located within city?
1 3/4 west of Oskaloosa

2 WATER WELL OWNER: Bob Best
RR#, St. Address, Box # : 10770 Perry Park Drive Board of Agriculture, Division of Water Resources
City, State, ZIP Code : Perry, KS 66073 Application Number:

3 LOCATE WELL'S LOCATION WITH AN "X" IN SECTION BOX: 4 DEPTH OF COMPLETED WELL 160' ft. ELEVATION:
Depth(s) Groundwater Encountered 1. 30' ft. 2. ft. 3. ft.
WELL'S STATIC WATER LEVEL 17' ft. below land surface measured on mo/day/yr 4-7-97
Pump test data: Well water was ft. after hours pumping gpm
Est. Yield 2 1/2 gpm: Well water was ft. after hours pumping gpm
Bore Hole Diameter 8 3/4 in. to ft. and in. to ft.
WELL WATER TO BE USED AS: 5 Public water supply 8 Air conditioning 11 Injection well
1 Domestic 3 Feedlot 6 Oil field water supply 9 Dewatering 12 Other (Specify below)
2 Irrigation 4 Industrial 7 Lawn and garden only 10 Monitoring well
Was a chemical/bacteriological sample submitted to Department? Yes No X; If yes, mo/day/yr sample was submitted
Water Well Disinfected? Yes X No

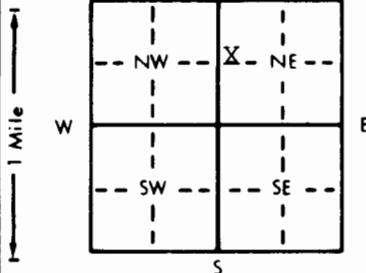

5 TYPE OF BLANK CASING USED: 5 Wrought iron 8 Concrete tile CASING JOINTS: Glued X Clamped
1 Steel 3 RMP (SR) 6 Asbestos-Cement 9 Other (specify below) Welded
2 PVC 4 ABS 7 Fiberglass Threaded
Blank casing diameter 5" in. to 0-21 ft., Dia 5" in. to 41-61 ft., Dia in. to ft.
Casing height above land surface 24" in., weight 2.82 lbs./ft. Wall thickness or gauge No. 258
TYPE OF SCREEN OR PERFORATION MATERIAL: 7 PVC 10 Asbestos-cement
1 Steel 3 Stainless steel 5 Fiberglass 8 RMP (SR) 11 Other (specify)
2 Brass 4 Galvanized steel 6 Concrete tile 9 ABS 12 None used (open hole)
SCREEN OR PERFORATION OPENINGS ARE: 5 Gauzed wrapped 8 Saw cut 11 None (open hole)
1 Continuous slot 3 Mill slot 6 Wire wrapped 9 Drilled holes
2 Louvered shutter 4 Key punched 7 Torch cut 10 Other (specify)
SCREEN-PERFORATED INTERVALS: From 21 ft. to 41 ft., From ft. to ft.
From 61 ft. to 81 ft., From ft. to ft.
GRAVEL PACK INTERVALS: From 21 ft. to 160 ft., From ft. to ft.
From ft. to ft., From ft. to ft.

6 GROUT MATERIAL: 1 Neat cement 2 Cement grout 3 Bentonite 4 Other
Grout Intervals: From 0 ft. to 21 ft., From ft. to ft., From ft. to ft.
What is the nearest source of possible contamination:
1 Septic tank 4 Lateral lines 7 Pit privy 10 Livestock pens 14 Abandoned water well
2 Sewer lines 5 Cess pool 8 Sewage lagoon 11 Fuel storage 15 Oil well/Gas well
3 Watertight sewer lines 6 Seepage pit 9 Feedyard 12 Fertilizer storage 16 Other (specify below)
13 Insecticide storage
Direction from well? North How many feet? 300'

FROM	TO	LITHOLOGIC LOG	FROM	TO	PLUGGING INTERVALS
0	14	Shale-Yellow	71	72	Sandstone-Grey
14	23	Shale-Grey	72	91	Shale-Grey
23	24	Limestone-Tan-Loose	91	95	Limestone-Grey
24	25	Shale-Grey	95	121	Shale-Grey
25	31	Limestone-Grey	121	127	Limestone-Grey
31	32	Shale-Grey	127	132	Shale-Grey
32	33	Limestone-Grey	132	152	Limestone-Grey
33	39	Shaley LS-Grey	152	158	Shale-Black
39	42	Shale-Black	158	159	LS-Grey-Flinty
42	46	Limestone-Grey	159	160	Shale-Grey
46	49	Shale-Grey			
49	50	Limestone-Grey-Loose			
50	52	Shale-Grey			
52	57	Limestone-Grey			
57	71	Shale-Grey			

7 CONTRACTOR'S OR LANDOWNER'S CERTIFICATION: This water well was (1) constructed, (2) reconstructed, or (3) plugged under my jurisdiction and was completed on (mo/day/year) 4-07-97 and this record is true to the best of my knowledge and belief. Kansas
Water Well Contractor's License No. 182 This Water Well Record was completed on (mo/day/yr) 4-16-97
under the business name of STRADER DRILLING CO., INC. by (signature) Dale Skren

OFFICE USE ONLY
T
R
EW
SEC
1/4
1/4
1/4