

94

2-1-80


USE TYPEWRITER OR BALL POINT PEN-PRESS FIRMLY, PRINT CLEARLY.

WATER WELL RECORD  
KSA 82a-1201-1215

Kansas Department of Health and Environment-Division of Environment  
(Water well Contractors)  
Topeka, Kansas 66620

Location of well: **JEFFERSON** County    Fraction: **SE 1/4 NW 1/4 NW 1/4**    Section number: **7**    Township number: **T 10 S R 18 E**    Range number: **18**

2. Distance and direction from nearest town or city: **2 1/4 MI S.E. OZAWKIE, KS**    3. Owner of well: **LAKWOOD HILLS DEVELOPMENT**  
Street address of well location if in city:    R.R. or street: **JEFF. CO. R.W.O. NO. 9**  
City, state, zip code: **OZAWKIE, KS.**

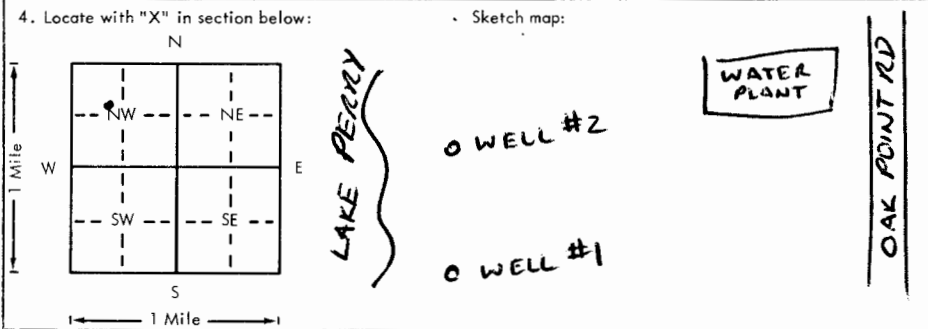

6. Bore hole dia. **30** in. Completion date **11-29-77**  
Well depth **54** ft.

7.  Cable tool     Rotary     Driven     Dug  
 Hollow rod     Jetted     Bored     Reverse rotary

8. Use:  Domestic     Public supply     Industry  
 Irrigation     Air conditioning     Stock  
 Lawn     Oil field water     Other

9. Casing: Material **STEEL** Height: **Above** or below  
Threaded  Welded  Surface **42** in.  
RMP  PVC  Weight **40.5** lbs./ft.  
Dia. **10** in. to **45** ft. depth Wall Thickness: inches or  
Dia.  in. to  ft. depth gage No. **.365**

5. Type and color of material	From	To
Brown silty clay	0	34 <sup>6</sup>
Brown silty clay	34 <sup>6</sup>	39
Gray silty clay	39	41 <sup>8</sup>
Brown medium to coarse sand, some fines	41 <sup>8</sup>	51
Brown medium to coarse sand, some gravel	51	53 <sup>4</sup>
Shale	53 <sup>4</sup>	
(Use a second sheet if needed)		

10. Screen: Manufacturer's name **JOHNSON**  
Type **WIKE WOUND** Dia. **10"**  
Slot/gauze **.035** Length **9'**  
Set between **45** ft. and **54** ft.  
ft. and  ft.  
Gravel pack? **YES** Size range of material **.06**

11. Static water level:  mo./day/yr.  
**25** ft. below land surface Date **12-1-77**

12. Pumping level below land surfaces:  
**38.6** ft. after **4** hrs. pumping **60** g.p.m.  
**40.0** ft. after **8** hrs. pumping **60** g.p.m.  
Estimated maximum yield **60** g.p.m.

13. Water sample submitted:  mo./day/yr.  
 Yes     No    Date **12/12/77**

14. Well head completion:  
 Pitless **UNIT** **12** Inches above grade

15. Well grouted?  **YES**  
With:  Neat cement     Bentonite     Concrete  
Depth: From **7** ft. to **20** ft.

16. Nearest source of possible contamination:  
ft. **900** Direction **WEST** Type **LAKE**  
Well disinfected upon completion?  Yes     No

17. Pump:  Not installed  
Manufacturer's name **JACUZZI**  
Model number **356B3** HP **3** Volts **230**  
Length of drop pipe **45** ft. capacity **50** g.p.m.  
Type:  
 Submersible     Turbine  
 Jet     Reciprocating  
 Centrifugal     Other

18. Elevation: **916**  
Topography:  Hill     Slope     Upland     Valley

19. Remarks: **912 RW**

20. Water well contractor's certification:  
This well was drilled under my jurisdiction and this report is true to the best of my knowledge and belief.  
**LAYNE WESTERN** License No. **149**  
Business name    License No.  
Address **1010 W 39 KCMO**  
Signed **D. O. B. [Signature]** Date **3/1/80**  
Authorized representative

T  
R  
W  
E  
S  
E  
C  
10  
180  
7  
SEALING