


1 LOCATION OF WATER WELL: County: JEFFERSON	Fraction NE $\frac{1}{4}$ SW $\frac{1}{4}$ SW $\frac{1}{4}$	Section Number 24	Township Number T 10 S	Range Number R 18 E
---	---	-----------------------------	----------------------------------	-------------------------------

Distance and direction from nearest town or city street address of well if located within city?
7 MILES NORTH - 1 1/4 WEST WILLIAMTOWN

2 WATER WELL OWNER: WAYNE WHITE
RR#, St. Address, Box # : RT #1 BOX 55B
City, State, ZIP Code : McLeath, KS 66054

Board of Agriculture, Division of Water Resources
Application Number:

LOCATE WELL'S LOCATION WITH AN "X" IN SECTION BOX: N 4. DEPTH OF COMPLETED WELL: 123 ft. ELEVATION: 61 ft.
Depth(s) Groundwater Encountered 1. 25 ft. 2. 61 ft. 3. 123 ft.

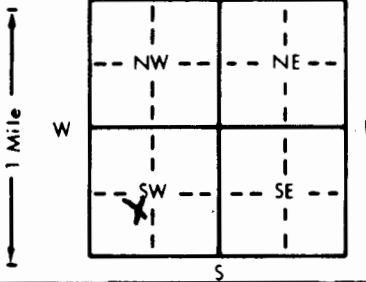

4. DEPTH OF COMPLETED WELL: 123 ft. ELEVATION: _____
Depth(s) Groundwater Encountered 1. 25 ft. 2. 61 ft. 3. 123 ft.

WELL'S STATIC WATER LEVEL 25 ft. below land surface measured on mo/day/yr 6-21-11
 Pump test data: Well water was _____ ft. after _____ hours pumping _____ gpm
6-21-11

Est. Yield 3000 gpm. Well water was _____ ft. after _____ hours pumping _____ gpm.
Bore Hole Diameter 9" in. to 125 ft. and _____ in. to _____ ft.

WELL WATER TO BE USED AS:			
1 Domestic	3 Feedlot	6 Oil field water supply	9 Dewatering
2 Irrigation	4 Industrial	7 Lawn and garden only	10 Monitoring well
			11 Injection well
			12 Other (Specify below)

Was a chemical/bacteriological sample submitted to Department? Yes.....No.....X.....; If yes, mo/day/yr sample was submitted
Water Well Disinfected? Yes.....X.....No.....

5	TYPE OF BLANK CASING USED:		5 Wrought iron	8 Concrete tile	CASING JOINTS: Glued <input checked="" type="checkbox"/> Clamped <input type="checkbox"/> Welded <input type="checkbox"/>
	1 Steel	3 RMP (SR)	6 Asbestos-Cement	9 Other (specify below)	

Blank casing diameter 5 in. to 40 ft., Dia 5 in. to 90 ft., Dia 5 in. to 125 ft.

Casing height above land surface. 24" in., weight lbs./ft. Wall thickness or gauge No. SDR-26
TYPE OF SCREEN OR PERFORATION MATERIAL: 7 PVC 10 Asbestos-cement

1 Steel	3 Stainless steel	5 Fiberglass	8 RMP (SR)	11 Other (specify)
2 Brass	4 Galvanized steel	6 Concrete tile	9 ABS	12 None used (open hole)

SCREEN OR PERFORATION OPENINGS ARE:

1 Continuous slot	3 Mill slot	5 Gauzed wrapped	8 Saw cut	11 None (open hole)
		6 Wire wrapped	9 Drilled holes	

2 Louvered shutter 4 Key punched 7 Torch cut 10 Other (specify) _____

SCREEN-PERFORATED INTERVALS: From 40 ft. to 50 ft., From _____ ft. to _____ ft.

GRAVEL PACK INTERVALS: From 90 ft. to 100 ft. From ft. to ft.
From 25 ft. to 125 ft. From ft. to ft.

		From	ft. to	ft., From	ft. to	ft.
6	GROUT MATERIAL:	1 Neat cement	2 Cement grout	3 Bentonite	4 Other	

Grout intervals: From 0 ft. to 2.5 ft., From _____ ft. to _____ ft., From _____ ft. to _____ ft.

What is the nearest source of possible contamination: 10 Livestock pens 14 Abandoned water well

1 Septic tank	4 Lateral lines	7 Pit privy	11 Fuel storage	15 Oil well/Gas well
2 Sewer lines	5 Cess pool	8 Sewage lagoon	12 Fertilizer storage	16 Other (specify below)

3 Watertight sewer lines 6 Seepage pit 9 Feedyard 13 Insecticide storage
Direction from well? None at time of drilling (on pasture) How many feet?

FROM		TO		LITHOLOGIC LOG	FROM		TO		PLUGGING INTERVALS
0	6				SOIL & CLAY				

6	15	SHELL ROCK			
15	61	SHALE			
61	73	LIME			
73	75	SHALE			
75	125	LIME			

7 CONTRACTOR'S OR LANDOWNER'S CERTIFICATION: This water well was (1) constructed, (2) reconstructed, or (3) plugged under my jurisdiction and was completed on (mo/day/year) 6-21-91 and this record is true to the best of my knowledge and belief. Kansas

Water Well Contractor's License No. 5386 This Water Well Record was completed on (mo/day/yr) 10-9-91
under the business name of Kitchen Pump & Well Drillings Inc. by (signature) Tom E. Kitchen