


1 LOCATION OF WATER WELL: Fraction NE 1/4 SE 1/4 SW 1/4 Section Number 29 Township Number T 10 S Range Number R 19 **EW**  
 County: JEFFERSON Distance and direction from nearest town or city street address of well if located within city?

4 1/2 south, 5/8 west of Oskaloosa

2 WATER WELL OWNER: Steve Moring RR#, St. Address, Box #: P.O. Box 366 City, State, ZIP Code: Moss Beach, California 94038 Board of Agriculture, Division of Water Resources Application Number:

3 LOCATE WELL'S LOCATION WITH AN "X" IN SECTION BOX:

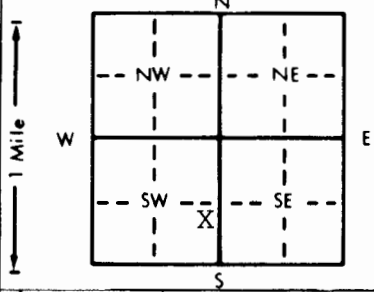

4 DEPTH OF COMPLETED WELL: 79' ft. ELEVATION: Depth(s) Groundwater Encountered 1. 30' ft. 2. ft. 3. ft. WELL'S STATIC WATER LEVEL: 20' ft. below land surface measured on mo/day/yr 5/9/97 Pump test data: Well water was ft. after hours pumping gpm Est. Yield 2 gpm Well water was ft. after hours pumping gpm Bore Hole Diameter .8 3/4 in. to ft. and in. to ft. WELL WATER TO BE USED AS: 5 Public water supply 8 Air conditioning 11 Injection well 1 Domestic 3 Feedlot 6 Oil field water supply 9 Dewatering 12 Other (Specify below) 2 Irrigation 4 Industrial 7 Lawn and garden only 10 Monitoring well Was a chemical/bacteriological sample submitted to Department? Yes No **X**; If yes, mo/day/yr sample was submitted Water Well Disinfected? Yes **X** No

5 TYPE OF BLANK CASING USED: 1 Steel 3 RMP (SR) 5 Wrought iron 8 Concrete tile CASING JOINTS: Glued **X** Clamped Welded Threaded 2 PVC 4 ABS 6 Asbestos-Cement 9 Other (specify below) 7 Fiberglass Blank casing diameter 5" in. to 0-27 ft., Dia 5" in. to 37-78 ft., Dia Casing height above land surface 24" in., weight 2.82 lbs./ft. Wall thickness or gauge No. 258 TYPE OF SCREEN OR PERFORATION MATERIAL: 1 Steel 3 Stainless steel 5 Fiberglass 7 PVC 10 Asbestos-cement 2 Brass 4 Galvanized steel 6 Concrete tile 8 RMP (SR) 11 Other (specify) 9 ABS 12 None used (open hole) SCREEN OR PERFORATION OPENINGS ARE: 1 Continuous slot 3 Mill slot 5 Gauzed wrapped 8 Saw cut 11 None (open hole) 2 Louvered shutter 4 Key punched 6 Wire wrapped 9 Drilled holes 7 Torch cut 10 Other (specify) SCREEN-PERFORATED INTERVALS: From 27 ft. to 37 ft., From 78 ft. to 79 ft., From GRAVEL PACK INTERVALS: From 24 ft. to 79 ft., From

6 GROUT MATERIAL: 1 Neat cement 2 Cement grout 3 Bentonite 4 Other Grout Intervals: From 4 ft. to 24 ft., From What is the nearest source of possible contamination: 1 Septic tank 4 Lateral lines 7 Pit privy 10 Livestock pens 14 Abandoned water well 2 Sewer lines 5 Cess pool 8 Sewage lagoon 11 Fuel storage 15 Oil well/Gas well 3 Watertight sewer lines 6 Seepage pit 9 Feedyard 12 Fertilizer storage 16 Other (specify below) 13 Insecticide storage creek Direction from well? west How many feet? 100'

FROM	TO	LITHOLOGIC LOG	FROM	TO	PLUGGING INTERVALS
0	4	Top Soil			
4	27	Clay-Brown			
27	29	Cherty Gravel, LS-Loose			
29	61	Shale-Grey			
61	62	Limestone-Grey			
62	63	Shale-Grey			
63	65	Limestone-Grey			
65	69	Shale-Grey			
69	73	Limestone-Grey			
73	79	Shale-Grey			

7 CONTRACTOR'S OR LANDOWNER'S CERTIFICATION: This water well was (1) constructed, (2) reconstructed, or (3) plugged under my jurisdiction and was completed on (mo/day/year) 5/9/97 and this record is true to the best of my knowledge and belief. Kansas Water Well Contractor's License No. 182 This Water Well Record was completed on (mo/day/yr) 5-21-97 under the business name of STRADER DRILLING CO., INC. by (signature) Dale Asker

OFFICE USE ONLY  
T  
R  
EW  
SEC.