


1 LOCATION OF WATER WELL: Fraction SW 1/4 SW 1/4 SE 1/4 Section Number 28 Township Number T 10 S Range Number R 19 **EW**
 County: JEFFERSON

Distance and direction from nearest town or city street address of well if located within city?
 5 miles south, 3/4 east of Oskaloosa

2 WATER WELL OWNER: Robert Lathrom
 RR#, St. Address, Box # : 5917 Bucks Creek Rd. Board of Agriculture, Division of Water Resources
 City, State, ZIP Code : Oskaloosa, KS 66066 Application Number:

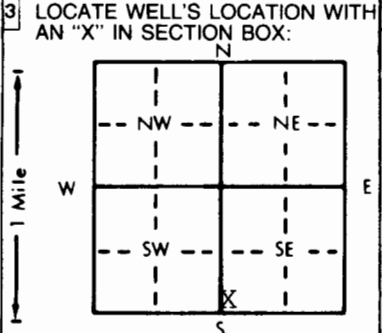

4 DEPTH OF COMPLETED WELL... 120' ft. ELEVATION:
 Depth(s) Groundwater Encountered 1. 38' ft. 2. ft. 3. ft.
 WELL'S STATIC WATER LEVEL... 35' ft. below land surface measured on mo/day/yr 2/06/98
 Pump test data: Well water was ft. after hours pumping gpm
 Est. Yield 30 GPH gpm: Well water was ft. after hours pumping gpm
 Bore Hole Diameter... in. to ft., and in. to ft.
 WELL WATER TO BE USED AS: 5 Public water supply 8 Air conditioning 11 Injection well
 1 Domestic 3 Feedlot 6 Oil field water supply 9 Dewatering 12 Other (Specify below)
 2 Irrigation 4 Industrial 7 Lawn and garden only 10 Monitoring well
 Was a chemical/bacteriological sample submitted to Department? Yes... No... **X**... If yes, mo/day/yr sample was submitted
 Water Well Disinfected? Yes **X** No

5 TYPE OF BLANK CASING USED: 5 Wrought iron 8 Concrete tile CASING JOINTS: Glued **X** Clamped
 1 Steel 3 RMP (SR) 6 Asbestos-Cement 9 Other (specify below) Welded
 2 PVC 4 ABS 7 Fiberglass Threaded
 Blank casing diameter 5" in. to 0-25 ft., Dia 5" in. to 40-119 ft., Dia in. to ft.
 Casing height above land surface 24" in., weight 2.82 lbs./ft. Wall thickness or gauge No. 258
 TYPE OF SCREEN OR PERFORATION MATERIAL: 7 PVC 10 Asbestos-cement
 1 Steel 3 Stainless steel 5 Fiberglass 8 RMP (SR) 11 Other (specify)
 2 Brass 4 Galvanized steel 6 Concrete tile 9 ABS 12 None used (open hole)
 SCREEN OR PERFORATION OPENINGS ARE: 5 Gauzed wrapped 8 Saw cut 11 None (open hole)
 1 Continuous slot 3 Mill slot 6 Wire wrapped 9 Drilled holes
 2 Louvered shutter 4 Key punched 7 Torch cut 10 Other (specify)
 SCREEN-PERFORATED INTERVALS: From 25 ft. to 40 ft., From ft. to ft.
 From 119 ft. to 120 ft., From ft. to ft.
 GRAVEL PACK INTERVALS: From 24 ft. to 120 ft., From ft. to ft.
 From ft. to ft., From ft. to ft.

6 GROUT MATERIAL: 1 Neat cement 2 Cement grout 3 Bentonite 4 Other
 Grout intervals: From 4 ft. to 24 ft., From ft. to ft., From ft. to ft.
 What is the nearest source of possible contamination:
 1 Septic tank 4 Lateral lines 7 Pit privy 10 Livestock pens 14 Abandoned water well
 2 Sewer lines 5 Cess pool 8 Sewage lagoon 11 Fuel storage 15 Oil well/Gas well
 3 Watertight sewer lines 6 Seepage pit 9 Feedyard 12 Fertilizer storage 16 Other (specify below)
 13 Insecticide storage
 Direction from well? East How many feet? 310'

FROM	TO	LITHOLOGIC LOG	FROM	TO	PLUGGING INTERVALS
0	5	Clay-Brown	101	102	Sandstone-Grey
5	23	Shale-Yellow	102	120	Shale-Grey
23	25	Limestone-Tan			
25	29	Shale-Grey			
29	31	Limestone-Tan			
31	33	Shale-Grey			
33	38	Limestone-Tan			
38	41	Shale-Black			
41	45	Limestone-Tan			
45	47	Shale-Grey			
47	52	Limestone-Grey			
52	56	Limestone-Tan			
56	83	Shale-Grey			
83	87	Limestone-Grey			
89	101	Shale-Grey			

7 CONTRACTOR'S OR LANDOWNER'S CERTIFICATION: This water well was (1) constructed, (2) reconstructed, or (3) plugged under my jurisdiction and was completed on (mo/day/year) 2/06/98 and this record is true to the best of my knowledge and belief. Kansas Water Well Contractor's License No. 182 This Water Well Record was completed on (mo/day/yr) 3-4-98 under the business name of STRADER DRILLING CO., INC. by (signature) Dale Askren

OFFICE USE ONLY