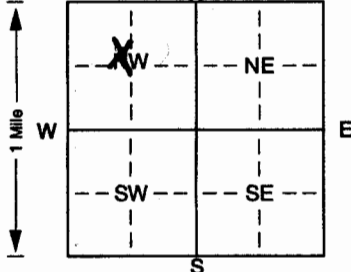


1 LOCATION OF WATER WELL: Fraction NW Section Number 8 Township Number 10 Range Number 2
 County: CLAY SE $\frac{1}{4}$ NW $\frac{1}{4}$ NE $\frac{1}{4}$ T S R W

Distance and direction from nearest town or city street address of well if located within city?
From WARRSALO: 10 MILES WEST, 1 SOUTH 3/4 WEST

2 WATER WELL OWNER: ROY HENRY
 RR#, St. Address, Box #: 415 Indian Rd
 City, State, ZIP Code: Longford, KS 67458
 Board of Agriculture, Division of Water Resources
 Application Number: _____

3 LOCATE WELL'S LOCATION WITH AN "X" IN SECTION BOX:

 DEPTH OF COMPLETED WELL: 140 ft. ELEVATION: _____
 Depth(s) Groundwater Encountered 1. 120 ft. 2. _____ ft. 3. _____ ft.
 WELL'S STATIC WATER LEVEL 9.7 ft. below land surface measured on mo/day/yr 6/22/04
 Pump test data: Well water was _____ ft. after _____ hours pumping _____ gpm
 Est. Yield 20 gpm: Well water was _____ ft. after _____ hours pumping _____ gpm
 Bore Hole Diameter: 9 in. to 140 ft., and _____ in. to _____ ft.
 WELL WATER TO BE USED AS:
 1 Domestic 3 Feedlot 6 Oil field water supply 9 Dewatering 12 Other (Specify below)
 2 Irrigation 4 Industrial 7 Domestic (lawn & garden) 10 Monitoring well
 Was a chemical/bacteriological sample submitted to Department? Yes. _____ No. X; If yes, mo/day/yr sample was submitted _____
 Water Well Disinfected? Yes X No _____

5 TYPE OF BLANK CASING USED:
 1 Steel PVC 3 RMP (SR) 5 Wrought iron 8 Concrete tile CASING JOINTS: Glued X Clamped _____
 4 ABS 6 Asbestos-Cement 9 Other (specify below) Welded _____
 7 Fiberglass Threaded _____
 Blank casing diameter 5 in. to 120 ft., Dia _____ in. to _____ ft., Dia _____ in. to _____ ft.
 Casing height above land surface: 2.4 in., weight _____ lbs./ft. Wall thickness or gauge No. 5 DR 21
 TYPE OF SCREEN OR PERFORATION MATERIAL:
 1 Steel 3 Stainless steel 5 Fiberglass 7 PVC 10 Asbestos-cement
 2 Brass 4 Galvanized steel 6 Concrete tile 8 RMP (SR) 11 Other (specify) _____
 9 ABS 12 None used (open hole)
 SCREEN OR PERFORATION OPENINGS ARE:
 1 Continuous slot 3 3 MILL SLOT 5 Gauzed wrapped 8 Saw cut 11 None (open hole)
 2 Louvered shutter 4 Key punched 6 Wire wrapped 9 Drilled holes
 7 Torch cut 10 Other (specify) _____ ft.
 SCREEN-PERFORATED INTERVALS: From 120 ft. to 140 ft., From _____ ft. to _____ ft.
 From _____ ft. to _____ ft., From _____ ft. to _____ ft.
 GRAVEL PACK INTERVALS: From 25 ft. to 140 ft., From _____ ft. to _____ ft.
 From _____ ft. to _____ ft., From _____ ft. to _____ ft.

6 GROUT MATERIAL: 1 Neat cement 2 Cement grout 3 Bentonite 4 Other _____
 Grout Intervals: From 3 ft. to 25 ft., From _____ ft. to _____ ft., From _____ ft. to _____ ft.
 What is the nearest source of possible contamination:
 1 Septic tank 4 Lateral lines 7 Pit privy 10 Livestock pens 14 Abandoned water well
 2 Sewer lines 5 Cess pool 8 Sewage lagoon 11 Fuel storage 15 Oil well/Gas well
 3 Watertight sewer lines 6 Seepage pit 9 Feedyard 12 Fertilizer storage 16 Other (specify below)
ON EDGE OF FIELD
 Direction from well? _____ How many feet? _____

FROM	TO	LITHOLOGIC LOG	FROM	TO	PLUGGING INTERVALS
0	6	SOIL			
6	56	CLAY, TAN			
56	115	SHALE, GRAY			
115	117	SHALE, RED			
117	120	SHALE, GRAY			
120	120.5	LEASSONITE, GRAY			
120.5	140	SHALE, GRAY			

7 CONTRACTOR'S OR LANDOWNER'S CERTIFICATION: This water well was (1) constructed, (2) reconstructed, or (3) plugged under my jurisdiction and was completed on (mo/day/year) 6/22/04 and this record is true to the best of my knowledge and belief. Kansas Water Well Contractor's Licence No. 585 This Water Well Record was completed on (mo/day/yr) 7/16/04
 under the business name of ASSOCIATED ENVIRONMENTAL INC. by (signature) _____