

KANSAS WELL SCHEDULE

Card 1

Record by Kleinschmidt Date: 2-28-73 Project: Top-KC State: Ks County: Jeff 49
 Latitude: _____ deg min sec Longitude: _____ deg min sec Accuracy: _____ Owner's well no: _____
 Location: SW NE SW no. sec. 21 T. 10 N., R. 20 E. Well number: 1030E2/CAC
 Owner: Theroff name McLouth address
 Owner: 15 16 17 18 19 20 21 22 23 24 25 26 27 28 29 30 31 32 33 34 35 36 37 38 THEROFF Altitude: _____ lsd _____ Accuracy _____
 Driller: Brewer Drilling name Busch Ks address Date drilled: Jan 20 1966
 Topography, well site: (D) _____ (F) _____ (L) _____ (R) _____ (S) _____ (T) _____ (U) u Spring; or depth of well: 100 _____ lsd _____ feet _____ accuracy _____
 Diameter: 4 _____ inches or feet _____ 51 52 Depth cased: 100 _____ 53 54 55 Spring, or Csg. type: std 5 Finish: _____ 57 Lift & power: Sub-elec 58
 Pump setting: _____ lsd _____ feet _____ 59 60 61 Use of well: Domestic, stock, irrigation, industrial, public supply, observation, none, test _____ 62
 Water level: 38 _____ above lsd _____ 38 R 3 _____ 63 64 65 accuracy _____ 66 date measured _____ 67 68 69 mon year Water level records avail. Drillers Log _____ 70
 Description MP: covered with large concrete slab _____ above lsd _____ below _____
 Yield: 159ph _____ 71 72 73 74 accuracy _____ 75 Pumping period: _____ hours or days _____ 76 77 Specific capacity: _____ gpm/ft. dd _____ 78 79
 Pumpage and other data available: _____ 80

Card 2

Coefficient trans: _____ gpd/ft _____ 15 16 17 Coefficient storage: _____ 18 19 20 Coefficient perm.: _____ gpd/ft² _____
 Aquifer, system or series _____ 21 _____ 22 _____ 23 _____ 24
 Aquifer, units _____ 25 26 27 _____ 28 29 30 _____ 31 32 33
 _____ 34 35 36 _____ 37 38 39 _____ 40 41 42 _____ 43 44 45
 Aquifer, thickness: _____ feet _____ 46 47 48 Aquifer, length of well open to: _____ feet _____ 49 50 51 Aquifer, depth to top of: _____ lsd _____ feet _____ 52 53 54 Aquifer, origin: _____
 Aquifer, lithology of: sandstone _____ 55 56 _____
 Bedrock, system: _____ 57 Bedrock, formation: _____ 58 59 60 Bedrock, depth to: _____ lsd _____ feet _____ 61 62 63
 Surficial material: _____ lithology _____ infiltration characteristics _____ Log data avail: Drillers Log _____ 64
 Quality of water data available: _____ 65 Temperature of water: _____ °F. _____ 66 67 Date sampled: _____ 68 69 70
 Coefficient of leakage _____

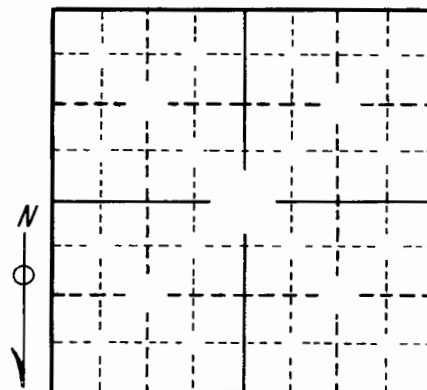
THE FOLLOWING DATA ARE USED ON THE NATIONAL WELL SCHEDULE

Ownership category: (C) _____ (F) _____ (M) _____ (N) _____ (P) _____ (S) _____ (W) _____ P
 County, Federal Gov't., City, Corp. or Co., Private, State Agency, Water Dist. _____ 71
 Method drilled: (A) _____ (B) _____ (C) _____ (D) _____ (V) _____ (H) _____ (J) _____ (R) _____ (T) _____ (S) _____ C
 Air, bored, cable, dug, driven, hyd. rotary, jetted, rev. rotary, trenching, spring, _____ 72
 Physiographic province: _____ 73 74 Section: _____
 Drainage basin: _____ 75 76 Subbasin: _____ Depth to basement: _____ 77 78 79 source of data (basement) _____ 80

Quadrangle McLouth

Well no. _____

A hand-drawn sketch of a road intersection. A vertical line on the left is labeled 'Co Road'. A horizontal line from the right is labeled 'Drive'. At the intersection, there is a circular feature labeled 'Well' and a small rectangular box labeled 'House'.

[illegible]