

# 2 with  
 ZIW  
 BRT

# WATER WELL RECORD

## DRILLERS LOG OF WELL

FROM (FT.)	TO (FT.)	KIND OF MATERIAL, COLOR, ETC. (NOTE WATER ZONES, AMOUNT, QUALITY)
0	2	Top Soil
21	16	Clay
16	38	Clay Sandy
38	55	Sandstone
55	62	Shale
62	64	Lime
64	75	Shale TD

Well Owner Mr -- Garatny

Address McLouth

Drilling Contractor Breuer Drilling Co.  
Basehor Kansas

Date Drilled July 11 - 1960

Method of Drilling Cable Tool  
(Cable tool, rotary, reverse rotary, etc.)

Casing Schedule 70 Ft. Plain Galv  
(Amount, Size, Setting—New, Used—Steel, Galv.—Gage or Weight)  
6Ft Perf Galv


Screen Data (if any): \_\_\_\_\_  
(Length, Diameter, Slot Size, Setting)

Measured depth to water on completed well (Static Level) is  
30 ft. below Land Surface  
(Land Surface, Top of Casing, Etc.)

TESTED YIELD: I gallons per Min  
(Min., Hour)

as determined by \_\_\_\_\_  
(Bailing, Test Pumping, Etc.)

DRAWDOWN: \_\_\_\_\_ ft. after \_\_\_\_\_ hrs.  
 pumping at \_\_\_\_\_ gal. per minute.

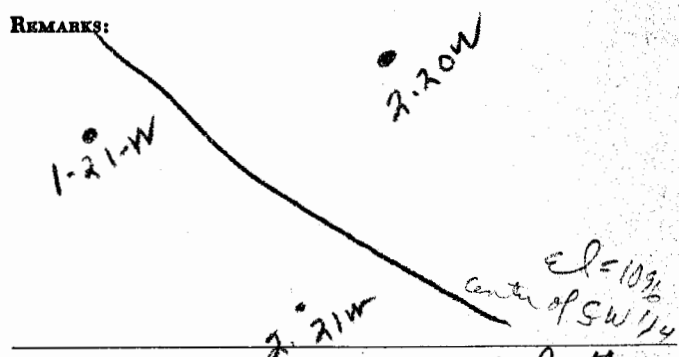


LOCATION OF WELL Topographic Sheet McLouth  
[Show location in Section Plat] Elev. \_\_\_\_\_

\_\_\_\_\_  $\frac{1}{4}$  SW  $\frac{1}{4}$  Sec. 22

T. 10 S., R. 20 E. W.

County Rear

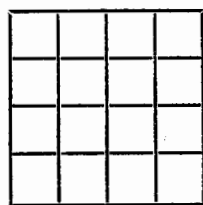

"To preserve water well information and to promote the conservation, protection, and development of ground-water resources."