White—Driller's Copy
Blue—Kansas Geological Survey, University of Kansas, Lawrence
Pink—Customer Copy

VBRT

1 with 20W

WATER WELL RECORD

DRILLERS LOG OF WELL

FROM (FT.)	TO (FT.)	KIND OF MATERIAL, COLOR, ETC. (NOTE WATER ZONES, AMOUNT, QUALITY)
0	1	Top Soil
1	47	Sandy Clay
47	52	Sandy Blue Shale
52	72	Sandstone, Gray
72	75	Sandy Shale

Well Owner: Mr. Garatny

Address: McLouth, Kansas

Drilling Contractor: Breuer Drilling Co.

Box 147, Basehor, Kansas

Date Drilled: July, 7, 1960

Method of Drilling: Cable Tool
(Cable tool, rotary, reverse rotary, etc.)

Casing Schedule: 63' plain Galv.
(Amount, Size, Setting—New, Used—Steel, Galv.—Gage or Weight)
12' perf. Galv.

Screen Data (if any): _____
(Length, Diameter, Slot Size, Setting)

Measured depth to water on completed well (Static Level) is

40 ft. below Land Surface
(Land Surface, Top of Casing, Etc.)

TESTED YIELD: 1½ gallons per Min
(Min., Hour)

as determined by Bailing
(Bailing, Test Pumping, Etc.)

DRAWDOWN: 1-20W ft. after _____ hrs.

pumping at _____ gal. per minute.

REMARKS:

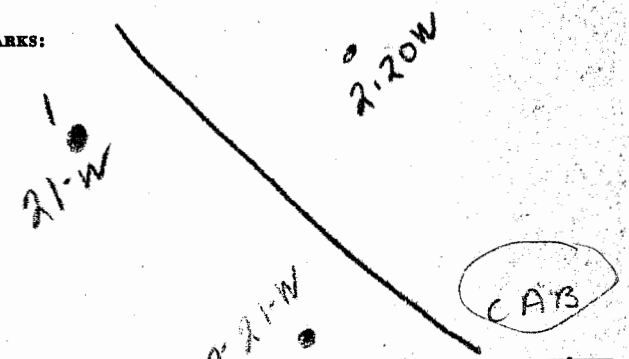

LOCATION OF WELL [Show location in Section Plat]

Topographic Sheet: McLouth

Elev. 1100+

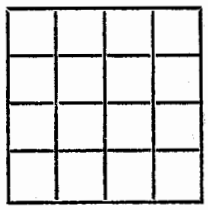

NW ¼ NW ¼ SW ¼ Sec. 22

T. 10 S., R. 20 E. W.

County: Leav

BR 1053

NP

"To preserve water well information and to promote the conservation, protection, and development of ground-water resources."

27-1467-S—27-32 10-57-5M SETS