


*William Burke*  
*Bill Mikisain*

# WATER WELL RECORD

## DRILLERS LOG OF WELL


FROM (FT.)	TO (FT.)	KIND OF MATERIAL, COLOR, ETC. (NOTE WATER ZONES, AMOUNT, QUALITY)
0	1	Top Soil
1	6	Clay
6	7	Broken Rock
7	44	Sandy Clay gravel (water)
44	69	Blue sandy shale
69	72	Lime
72	100	Sandy shale
100	130	Lime
130	135	Slate
135	137	Lime
137	140	Lime T.D.

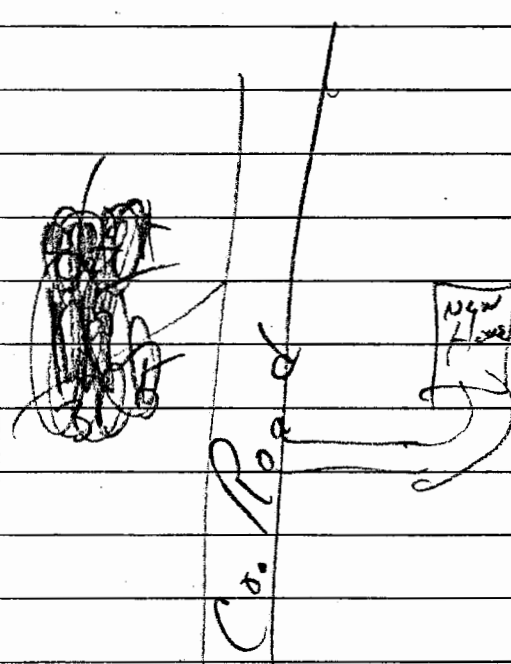

Well Owner Bill Mikisain  
 Address Southeast of McLouth (Stanwood church) area  
 Drilling Contractor Breuer drilling Co.  
Basehor, Kans.  
 Date Drilled 6-7-68  
 Method of Drilling Cable Tool  
(Cable tool, rotary, reverse rotary, etc.)  
 Casing Schedule 141 ft. 6 1/2 steel  
(Amount, Size, Setting—New, Used—Steel, Galv.—Gage or Weight)  
 Screen Data (if any): \_\_\_\_\_  
(Length, Diameter, Slot Size, Setting)

Measured depth to water on completed well (Static Level) is 30 ft. below land surface  
(Land Surface, Top of Casing, Etc.)  
20 hr.  
 TESTED YIELD: \_\_\_\_\_ gallons per \_\_\_\_\_ (Min., Hour)  
 as determined by bailing  
(Bailing, Test Pumping, Etc.)  
 DRAWDOWN: \_\_\_\_\_ ft. after \_\_\_\_\_ hrs.  
 pumping at \_\_\_\_\_ gal. per minute.

REMARKS: Feb 25 ft Reported  
CCD

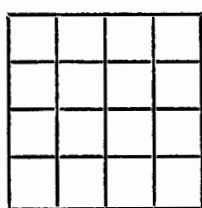LOCATION OF WELL Topographic Sheet McLouth  
 [Show location in Section Plat] Elev. 1110  

 SW  $\frac{1}{4}$  SW  $\frac{1}{4}$  Sec. 22  
 T. 10 S., R. 20 E. W.  
 County Rear



BR = 1066