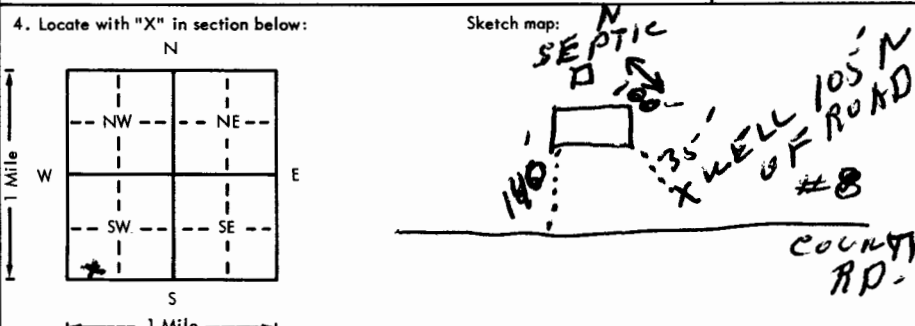


USE TYPEWRITER OR BALL POINT PEN-PRESS FIRMLY, PRINT CLEARLY.

WATER WELL RECORD
KSA 82a-1201-1215

Kansas Department of Health and Environment-Division of Environment (Water well Contractors) Topeka, Kansas 66620

1. Location of well:	County Leavenworth	Fraction SW 1/4 SW 1/4 SW 1/4	Section number 3	Township number T 10S S R	Range number 21E E/W																											
2. Distance and direction from nearest town or city: 8 mi. N.E. of Tonganoxie, Ks. Street address of well location if in city:			3. Owner of well: H. W. Nolte R.R. or street: R.1 Box 140C City, state, zip code: Leavenworth, Ks.																													
4. Locate with "X" in section below: 			6. Bore hole dia. 8 1/2 in. Completion date 1-4-76 Well depth 150 ft.																													
5. Type and color of material			7. <input checked="" type="checkbox"/> Cable tool <input type="checkbox"/> Rotary <input type="checkbox"/> Driven <input type="checkbox"/> Dug <input type="checkbox"/> Hollow rod <input type="checkbox"/> Jetted <input type="checkbox"/> Bored <input type="checkbox"/> Reverse rotary																													
<table border="1" style="width:100%; border-collapse: collapse;"> <thead> <tr> <th></th> <th>From</th> <th>To</th> </tr> </thead> <tbody> <tr> <td>Surface clay brown</td> <td>0</td> <td>8</td> </tr> <tr> <td>Sandy clay brown</td> <td>8</td> <td>26</td> </tr> <tr> <td>Gravel</td> <td>26</td> <td>27</td> </tr> <tr> <td>Sandstone brown</td> <td>27</td> <td>46</td> </tr> <tr> <td>Shale blue</td> <td>46</td> <td>60</td> </tr> <tr> <td>Shale gray</td> <td>60</td> <td>142</td> </tr> <tr> <td>Lime gray</td> <td>142</td> <td>148</td> </tr> <tr> <td>Shale gray</td> <td>148</td> <td>150</td> </tr> </tbody> </table>				From	To	Surface clay brown	0	8	Sandy clay brown	8	26	Gravel	26	27	Sandstone brown	27	46	Shale blue	46	60	Shale gray	60	142	Lime gray	142	148	Shale gray	148	150	8. Use: <input checked="" type="checkbox"/> Domestic <input type="checkbox"/> Public supply <input type="checkbox"/> Industry <input type="checkbox"/> Irrigation <input type="checkbox"/> Air conditioning <input type="checkbox"/> Stock <input type="checkbox"/> Lawn <input type="checkbox"/> Oil field water <input type="checkbox"/> Other		
	From	To																														
Surface clay brown	0	8																														
Sandy clay brown	8	26																														
Gravel	26	27																														
Sandstone brown	27	46																														
Shale blue	46	60																														
Shale gray	60	142																														
Lime gray	142	148																														
Shale gray	148	150																														
			9. Casing: Material RMP Height: Above or below Threaded <input type="checkbox"/> Welded <input checked="" type="checkbox"/> Surface 12 in. RMP <input checked="" type="checkbox"/> PVC <input type="checkbox"/> Weight 1 1/2 lbs./ft. Dia. 5 in. to 150 ft. depth Wall thickness: inches or Dia. <input type="checkbox"/> in. to <input type="checkbox"/> ft. depth Gage No. 1/4																													
			10. Screen: Manufacturer's name Pioneer Mfg. Co. Type RMP Dia. 5 " Slot/gauze See note Length <input checked="" type="checkbox"/> 130' Set between 20 ft. and 150 ft. ft. and <input type="checkbox"/> ft. Gravel pack? <input checked="" type="checkbox"/> Size range of material 1/4 x 1/8 "																													
			11. Static water level: 30 ft. below land surface Date 1-4-76 mo./day/yr.																													
			12. Pumping level below land surfaces: not pumped ft. after hrs. pumping g.p.m. ft. after hrs. pumping g.p.m. Estimated maximum yield 30 g.p.m.																													
			13. Water sample submitted: Yes <input type="checkbox"/> No <input checked="" type="checkbox"/> Date _____ mo./day/yr.																													
			14. Well head completion: _____ Pitless adapter _____ Inches above grade																													
			15. Well grouted? <input checked="" type="checkbox"/> With: <input type="checkbox"/> Neat cement <input checked="" type="checkbox"/> Bentonite <input type="checkbox"/> Concrete Depth: From 5 ft. to 20 ft.																													
			16. Nearest source of possible contamination: 100 ft. Direction NW Type SEPTIC Well disinfected upon completion? <input checked="" type="checkbox"/> Yes <input type="checkbox"/> No																													
			17. Pump: <input checked="" type="checkbox"/> Not installed Manufacturer's name _____ Model number _____ HP _____ Volts _____ Length of drop pipe _____ ft. capacity _____ g.p.m. Type: _____ Submersible _____ Turbine _____ Jet _____ Reciprocating _____ Centrifugal _____ Other																													
			20. Water well contractor's certification: This well was drilled under my jurisdiction and this report is true to the best of my knowledge and belief. F. E. Young Drilling 040 Business name _____ License No. _____ Address 6355 Robinhood, Merriam, Ks. Signed F.E. Young Date 2-16-76 Authorized representative																													
18. Elevation: 965' Topography: <input checked="" type="checkbox"/> Hill <input type="checkbox"/> Slope <input type="checkbox"/> Upland <input type="checkbox"/> Valley			19. Remarks: Customer aware of regulation and agrees to install concrete slab around casing <i>X HW Nolte III</i> Note; Slot size. All casing perforated with 3/32 drill from bottom of well.																													

Forward the white, blue and pink copies to the Department of Health and Environment

Form WWC-5