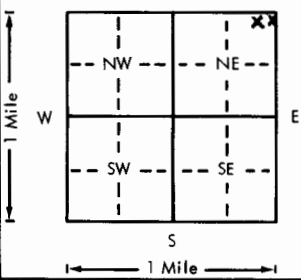


USE TYPEWRITER OR BALL POINT PEN-PRESS FIRMLY, PRINT CLEARLY.

WATER WELL RECORD
KSA 82a-1201-1215

Kansas Department of Health and Environment-Division of Environment (Water well Contractors) Topeka, Kansas 66620

NW

1. Location of well:	County Leavenworth	Fraction NE 1/4 NE 1/4 NE 1/4	Section number 11	Township number 10	Range number 21
2. Distance and direction from nearest town or city: Street address of well location if in city: Jarbalo, Kansas			3. Owner of well: R.R. or street: Mr. Frank Burwell Route 1 Box 222 City, state, zip code: Leavenworth, Kansas		
4. Locate with "X" in section below: N W E S 1 Mile		Sketch map: 		6. Bore hole dia. <u>8</u> in. Completion date <u>12-19-77</u> Well depth <u>100</u> ft.	
5. Type and color of material		From		To	
		Top Soil		0 3	
		Sandy Clay		3 19	
		Slate & Sand		19 25	
		Gravel & Sand		25 45	
Shale		45 100		7. <input checked="" type="checkbox"/> Cable tool <input checked="" type="checkbox"/> Rotary <input type="checkbox"/> Driven <input type="checkbox"/> Dug <input type="checkbox"/> Hollow rod <input type="checkbox"/> Jetted <input type="checkbox"/> Bored <input type="checkbox"/> Reverse rotary	
				8. Use: <input checked="" type="checkbox"/> Domestic <input type="checkbox"/> Public supply <input type="checkbox"/> Industry <input type="checkbox"/> Irrigation <input type="checkbox"/> Air conditioning <input type="checkbox"/> Stock <input type="checkbox"/> Lawn <input type="checkbox"/> Oil field water <input type="checkbox"/> Other	
				9. Casing: Material <u>PL</u> Height: Above or below Threaded <input type="checkbox"/> Welded <input checked="" type="checkbox"/> Surface <u>18</u> in. RMP <input type="checkbox"/> PVC <input checked="" type="checkbox"/> Weight _____ lbs./ft. Dia. <u>5</u> in. to <u>100</u> ft. depth Wall Thickness: inches or Dia. _____ in. to _____ ft. depth gage No. <u>265</u>	
				10. Screen: Manufacturer's name (<u>Slotted Pipe</u>) <u>Vinylplex, Inc.</u> Type <u>PVC</u> Dia. <u>5"</u> Slot/gauze <u>06 1/16</u> Length <u>20'</u> Set between <u>25</u> ft. and <u>45</u> ft. _____ ft. and _____ ft. Gravel pack? <input checked="" type="checkbox"/> Size range of material <u>1/4 - 1/8</u>	
				11. Static water level: _____ mo./day/yr. <u>20</u> ft. below land surface Date <u>12-19-77</u>	
				12. Pumping level below land surfaces: _____ ft. after _____ hrs. pumping _____ g.p.m. _____ ft. after _____ hrs. pumping _____ g.p.m. Estimated maximum yield <u>4</u> g.p.m.	
				13. Water sample submitted: _____ mo./day/yr. <input type="checkbox"/> Yes <input checked="" type="checkbox"/> No Date _____	
				14. Well head completion: <input checked="" type="checkbox"/> Pitless adapter <u>18</u> Inches above grade	
				15. Well grouted? <u>Yes</u> With: <input checked="" type="checkbox"/> Neat cement <input type="checkbox"/> Bentonite <input type="checkbox"/> Concrete Depth: From <u>3</u> ft. to <u>20</u> ft.	
				16. Nearest source of possible contamination: ft. <u>200</u> Direction <u>NE</u> Type <u>Septic</u> Well disinfected upon completion? <input checked="" type="checkbox"/> Yes <input type="checkbox"/> No	
				17. Pump: <input checked="" type="checkbox"/> Not installed Manufacturer's name _____ Model number _____ HP _____ Volts _____ Length of drop pipe _____ ft. capacity _____ g.p.m. Type: <input type="checkbox"/> Submersible <input type="checkbox"/> Turbine <input type="checkbox"/> Jet <input type="checkbox"/> Reciprocating <input type="checkbox"/> Centrifugal <input type="checkbox"/> Other	
		(Use a second sheet if needed)			
18. Elevation: <u>910</u> Topography: <input type="checkbox"/> Hill <input type="checkbox"/> Slope <input type="checkbox"/> Upland <input type="checkbox"/> Valley		19. Remarks:		20. Water well contractor's certification: This well was drilled under my jurisdiction and this report is true to the best of my knowledge and belief. <u>BREUER, INC.</u> <u>174</u> Business name License No. Address <u>Box 174 Basehor, Ks. 66008</u> Signed <u>[Signature]</u> Date <u>1-5</u> Authorized representative	

T
R
E
C
10
210
11
NE NE NE
1/4 Sec 11