


1 LOCATION OF WATER WELL: County: **LEAVENWORTH** Fraction: **NW 1/4 SE 1/4 NE 1/4** Section Number: **28** Township Number: **T 10 S** Range Number: **R 21 E**

Distance and direction from nearest town or city street address of well if located within city?
3 miles N of Tonganoxie

2 WATER WELL OWNER: **DR MARK PETERSON**
 RR#, St. Address, Box #: **120 N PETLETON**
 City, State, ZIP Code: **BONNER SPRINGS KS 66012**
 Board of Agriculture, Division of Water Resources
 Application Number:

3 LOCATE WELL'S LOCATION WITH AN "X" IN SECTION BOX:

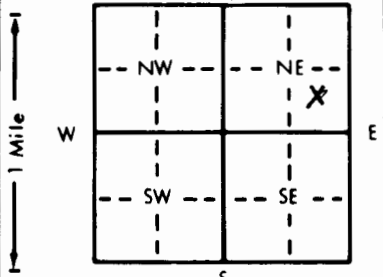

4 DEPTH OF COMPLETED WELL: **100'** ft. ELEVATION:
 Depth(s) Groundwater Encountered 1. **N/A** ft. 2. ft. 3. ft.
 WELL'S STATIC WATER LEVEL ft. below land surface measured on mo/day/yr
 Pump test data: Well water was ft. after hours pumping gpm
 Est. Yield **-0-** gpm: Well water was ft. after hours pumping gpm
 Bore Hole Diameter .in. to .ft., and .in. to .ft.

WELL WATER TO BE USED AS:
 1 Domestic 3 Feedlot 6 Oil field water supply 9 Dewatering 12 Other (Specify below)
 2 Irrigation 4 Industrial 7 Lawn and garden only 10 Monitoring well
 Was a chemical/bacteriological sample submitted to Department? Yes.....No.....; If yes, mo/day/yr sample was submitted
 Water Well Disinfected? Yes No

5 TYPE OF BLANK CASING USED: **N/A**
 1 Steel 3 RMP (SR) 5 Wrought iron 8 Concrete tile CASING JOINTS: Glued Clamped
 2 PVC 4 ABS 6 Asbestos-Cement 9 Other (specify below) Welded
 7 Fiberglass **NONE** Threaded

Blank casing diameter **Ø 999** in. to .ft., Dia .in. to .ft., Dia .in. to .ft.
 Casing height above land surface **0 999** in., weight lbs./ft. Wall thickness or gauge No.

TYPE OF SCREEN OR PERFORATION MATERIAL:
 1 Steel 3 Stainless steel 5 Fiberglass 8 RMP (SR) 11 Other (specify) **NA**
 2 Brass 4 Galvanized steel 6 Concrete tile 9 ABS 12 None used (open hole)

SCREEN OR PERFORATION OPENINGS ARE:
 1 Continuous slot 3 Mill slot 5 Gauzed wrapped 8 Saw cut 11 None (open hole)
 2 Louvered shutter 4 Key punched 6 Wire wrapped 9 Drilled holes
 7 Torch cut 10 Other (specify) **NA**

SCREEN-PERFORATED INTERVALS: From .ft. to .ft., From .ft. to .ft., From .ft. to .ft.
 GRAVEL PACK INTERVALS: From **100** ft. to **24** ft., From .ft. to .ft., From .ft. to .ft.

6 GROUT MATERIAL: 1 Neat cement 2 Cement grout **3 Bentonite** 4 Other
 Grout Intervals: From **24** ft. to **4** ft., From .ft. to .ft., From .ft. to .ft.

What is the nearest source of possible contamination:
 1 Septic tank 4 Lateral lines 7 Pit privy 10 Livestock pens 14 Abandoned water well
 2 Sewer lines 5 Cess pool 8 Sewage lagoon 11 Fuel storage 15 Oil well/Gas well
 3 Watertight sewer lines 6 Seepage pit 9 Feedyard 12 Fertilizer storage 16 Other (specify below)
 13 Insecticide storage
 Direction from well? How many feet?

FROM	TO	LITHOLOGIC LOG	FROM	TO	PLUGGING INTERVALS
0	8	Top soil			
8	38	CLAY Brown			
38	73	SANDY SOIL			
73	74	lime			
74	100	SHALE			
Dry Hole					

7 CONTRACTOR'S OR LANDOWNER'S CERTIFICATION: This water well was (1) constructed, (2) reconstructed, or (3) plugged under my jurisdiction and was completed on (mo/day/year) **6-15-93** and this record is true to the best of my knowledge and belief. Kansas Water Well Contractor's License No. **174** This Water Well Record was completed on (mo/day/yr) **6-17-93** under the business name of **GREUER INC** by (signature) **John S. Greuer**