USE TYPEWRITER OR BALL POINT PEN-PRESS FIRMLY, PRINT CLEARLY.

WATER WELL RECORD
KSA 82a-1201-1215

Kansas Department of Health and Environment-Division of Environment
(Water well Contractors)
Topeka, Kansas 66620

1. Location of well:	County	Fraction	Section number	Township number	Range number
	Leavenworth	NW 1/4 NW 1/4 SE 1/4	30	T 19 10 S	R 21 E/W

2. Distance and direction from nearest town or city: 3 miles north & 2 miles west of Tonganoxie, Kansas
Street address of well location if in city:

3. Owner of well: Miss Marilyn Powers
R.R. or street: R. R. #2
City, state, zip code: Tonglanoxie, Kansas

4. Locate with "X" in section below: Sketch map:

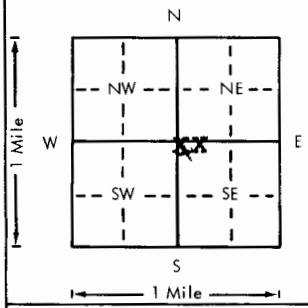

6. Bore hole dia. 8 in. Completion date 6-18-78
Well depth 100 ft.

7. __ Cable tool X Rotary __ Driven __ Dug
__ Hollow rod __ Jetted __ Bored __ Reverse rotary

8. Use: X Domestic __ Public supply __ Industry
__ Irrigation __ Air conditioning __ Stock
__ Lawn __ Oil field water __ Other

9. Casing: Material PL. Height: Above or below
Threaded ___ Welded X Surface 18 in.
RMP ___ PVC X Weight ___ lbs./ft.
Dia 5 in. to 102 ft. depth Wall Thickness: inches or
Dia. ___ in. to ___ ft. depth gage No. .265

10. Screen: Manufacturer's name (Slotted Pipe) Vinyiplex, Inc.
Type PVC Dia. 5"
Slot/gauze .06 1/16 Length 10'
Set between 35 ft. and 45 ft.
___ ft. and ___ ft.
Gravel pack? X Size range of material 1/8 - 1/8

11. Static water level: mo./day/yr.
15 ft. below land surface Date 6-18-78

12. Pumping level below land surfaces:
___ ft. after ___ hrs. pumping ___ g.p.m.
___ ft. after ___ hrs. pumping ___ g.p.m.
Estimated maximum yield 5 g.p.m.

13. Water sample submitted: mo./day/yr.
__ Yes X No Date

14. Well head completion:
X Pitless adapter 18 Inches above grade

15. Well grouted? Yes
With: X Neat cement __ Bentonite __ Concrete
Depth: From 3 ft. to 15 ft.

16. Nearest source of possible contamination:
ft. 150 Direction east Type septic
Well disinfected upon completion? ___ Yes ___ No

17. Pump: ___ Not installed
Manufacturer's name Jacuzzi
Model number S JD HP 1/2 Volts 230
Length of drop pipe 90 ft. capacity 8 g.p.m.
Type:
__ Submersible __ Turbine
XX Jet __ Reciprocating
__ Centrifugal __ Other

5. Type and color of material	From	To
Top Soil	0	3
Clay	3	26
Blue Mud	26	38
Gravel	38	43
Lime	43	46
Shale	46	100

(Use a second sheet if needed)

18. Elevation: 1067
Topography:
__ Hill
__ Slope
__ Upland
__ Valley

19. Remarks:

20. Water well contractor's certification:
This well was drilled under my jurisdiction and this report is true to the best of my knowledge and belief.
BREUER, INC. 174
Business name License No.
Address Box 147, Basehor, Ks.
Signed Raphael A Breuer Date 6/7/78
Authorized Representative

T 10 R 21 E/W Sec 30 1/4 1/4 1/4 1/4 NW NW SE

Forward the white, blue and pink copies to the Department of Health and Environment

Form WWC-5