


1 LOCATION OF WATER WELL: Fraction Section Number Township Number Range Number
 County: LEAVENWORTH NW ¼ SW ¼ NE ¼ 35 T 10S S R 21E EW

Distance and direction from nearest town or city street address of well if located within city?

2 WATER WELL OWNER: Darrel Miller
 RR#, St. Address, Box #: 20342 199th Street For John Breuer Board of Agriculture, Division of Water Resources
 City, State, ZIP Code: Tonganoxie, KS 66086 Application Number:

3 LOCATE WELL'S LOCATION WITH AN "X" IN SECTION BOX: DEPTH OF COMPLETED WELL... 148' ft. ELEVATION: ...
 Depth(s) Groundwater Encountered 1. ... ft. 2. ... ft. 3. ... ft.
 WELL'S STATIC WATER LEVEL ... 110' ft. below land surface measured on mo/day/yr 10-11-93
 Pump test data: Well water was ... ft. after ... hours pumping ... gpm
 Est. Yield 13 ... gpm: Well water was ... ft. after ... hours pumping ... gpm
 Bore Hole Diameter ... 8 3/4 in. to ... ft., and ... in. to ... ft.
 WELL WATER TO BE USED AS: 5 Public water supply 8 Air conditioning 11 Injection well
 1 Domestic 3 Feedlot 6 Oil field water supply 9 Dewatering 12 Other (Specify below)
 2 Irrigation 4 Industrial 7 Lawn and garden only 10 Monitoring well
 Was a chemical/bacteriological sample submitted to Department? Yes... No... X...; If yes, mo/day/yr sample was sub-
 mitted Water Well Disinfected? Yes X No

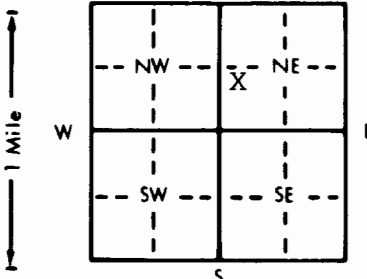

5 TYPE OF BLANK CASING USED: 5 Wrought iron 8 Concrete tile CASING JOINTS: Glued X Clamped
 1 Steel 3 RMP (SR) 6 Asbestos-Cement 9 Other (specify below) Welded
 2 PVC 4 ABS 7 Fiberglass Threaded
 Blank casing diameter ... 5" in. to 0-128 ft., Dia ... in. to ... ft., Dia ... in. to ... ft.
 Casing height above land surface ... 24" in., weight 2.82 lbs./ft. Wall thickness or gauge No. .258
 TYPE OF SCREEN OR PERFORATION MATERIAL: 7 PVC 10 Asbestos-cement
 1 Steel 3 Stainless steel 5 Fiberglass 8 RMP (SR) 11 Other (specify)
 2 Brass 4 Galvanized steel 6 Concrete tile 9 ABS 12 None used (open hole)
 SCREEN OR PERFORATION OPENINGS ARE: 5 Gauzed wrapped 8 Saw cut 11 None (open hole)
 1 Continuous slot 3 Mill slot 6 Wire wrapped 9 Drilled holes
 2 Louvered shutter 4 Key punched 7 Torch cut 10 Other (specify)
 SCREEN-PERFORATED INTERVALS: From ... 128 ft. to ... 148 ft., From ... ft. to ... ft.
 GRAVEL PACK INTERVALS: From ... ft. to ... ft., From ... ft. to ... ft.

6 GROUT MATERIAL: 1 Neat cement 2 Cement grout 3 Bentonite 4 Other
 Grout Intervals: From ... 0 ft. to ... 20' ft., From ... ft. to ... ft., From ... ft. to ... ft.
 What is the nearest source of possible contamination:
 1 Septic tank 4 Lateral lines 7 Pit privy 10 Livestock pens 14 Abandoned water well
 2 Sewer lines 5 Cess pool 8 Sewage lagoon 11 Fuel storage 15 Oil well/Gas well
 3 Watertight sewer lines 6 Seepage pit 9 Feedyard 12 Fertilizer storage 16 Other (specify below)
 13 Insecticide storage
 Direction from well? NW How many feet? 200'

FROM	TO	LITHOLOGIC LOG	FROM	TO	PLUGGING INTERVALS
0	2	Top Soil			
2	6	Clay-Brown			
6	13	Boulders, Clay-Yellow			
13	17	Shale-Grey			
17	26	Sandstone-Brown			
26	35	Shale-Grey			
35	51	Sandstone-Grey			
51	58	Shale-Grey			
58	95	Sandstone-Grey			
95	101	Shale-Grey			
101	148	Sandstone-Grey			
148		Limestone-Hard-Grey			

7 CONTRACTOR'S OR LANDOWNER'S CERTIFICATION: This water well was (1) constructed, (2) reconstructed, or (3) plugged under my jurisdiction and was completed on (mo/day/year) 10-11-93 and this record is true to the best of my knowledge and belief. Kansas Water Well Contractor's License No. 182 This Water Well Record was completed on (mo/day/yr) 11-16-93 under the business name of STRADER DRILLING CO., INC. by (signature) Darrel Miller

OFFICE USE ONLY

T

R

EW

SEC

1/4

1/4

1/4