

KANSAS WELL SCHEDULE

Card 1

5-2-0
1:22

Record by K. Schmidt Date: 4-4-77 Project: Top-KC State: Kan County: Leaw 52

Latitude: _____ Longitude: _____ Accuracy: _____ Owner's well no: _____

Location: SW NW SE no. sec. 22 T. 10 N., R. 21 E. Well number: 1021E22DBE

Owner: Bill McCraw Box 464 Tonganoxie Mo

Owner: BILL MCCRAW Altitude: 845 845 Accuracy: 3

Driller: Breuer Drilling Date drilled: 8-29-72

Topography, well site: (D) Draw, flood plain, lowland, (R) rolling, slope, (S) terrace, (T) upland. Spring or depth of well: 81 accuracy: 3

Diameter: 6 1/4 inches or feet. Depth cased: 81 feet. Spring, or Csg. type: stud Finish: Sub-e/ce Lift & power: Q

Pump setting: _____ Use of well: Domestic stock, irrigation, industrial, public supply, observation, none, test

Water level: 8.6 above lsd. 86 m 14-4-77 D73 Water level records avail. _____

Description MP: Top Casing 0.6' above yard

Yield: 30 gpm. Accuracy: 30 R 3 Pumping period: _____ Specific capacity: _____

Pumpage and other data available: _____

Card 2

Coefficient trans: _____ Coefficient storage: _____ Coefficient perm.: _____

Aquifer, system or series: _____

Aquifer, units: _____

Aquifer, thickness: _____ Aquifer, length of well open to: _____ Aquifer, depth to top of: _____ Aquifer, origin: _____

Aquifer, lithology of: _____

Bedrock, system: _____ Bedrock, formation: _____ Bedrock, depth to: _____

Surficial material: _____ Log data avail: _____

Quality of water data available: _____ Temperature of water: _____ Date sampled: _____

Coefficient of leakage: _____

THE FOLLOWING DATA ARE USED ON THE NATIONAL WELL SCHEDULE

Ownership category: (C) County, (F) Federal Gov't., (M) City, (N) Corp. or Co., (P) Private, (S) State Agency, (W) Water Dist. P

Method drilled: (A) Air, (B) bored, (C) cable, (D) dug, (V) driven, (H) hyd. rotary, (J) jetted, (R) rev. rotary, (T) trenching, (S) spring. C

Physiographic province: _____ Section: _____


Drainage basin: _____ Subbasin: _____ Depth to basement: _____ source of data (basement) _____

Quadrangle _____

Well no. _____

15.0
5.8
9.2
0.6
4.6

Jarbal Rd. Co Highway

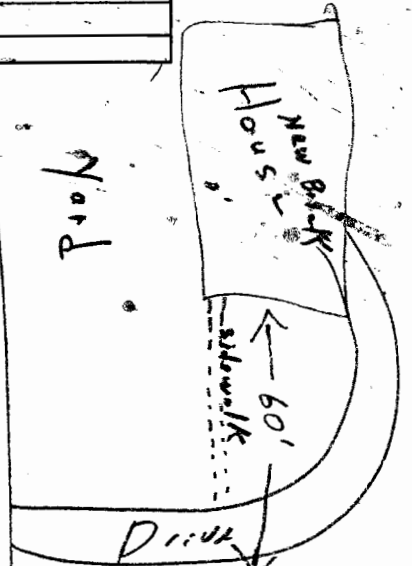

Nord

Well
 Well property is small

Co. Rd

