

3225 N. 80 Place
 CY-9-4046
 VBRT

WATER WELL RECORD

DRILLERS LOG OF WELL

Henry
~~Henry~~


Address tonganoxie, Ks.

Drilling Contractor Breuer Drilling Co.

Basehor, Ks.

Date Drilled 6-3-68

Method of Drilling Cable Tool
 (Cable tool, rotary, reverse rotary, etc.)

Casing Schedule 45 ft. 6 1/2 steel
 (Amount, Size, Setting—New, Used—Steel, Galv.—Cage or Weight)

Screen Data (if any): _____
 (Length, Diameter, Slot Size, Setting)

Measured depth to water on completed well (Static Level) is

10 ft. below land surface
 (Land Surface, Top of Casing, Etc.)

TESTED YIELD: 18 gallons per min.
 (Min., Hour)

as determined by bailing
 (Bailing, Test Pumping, Etc.)

DRAWDOWN: _____ ft. after _____ hrs.

pumping at _____ gal. per minute.

REMARKS: Well along Stranger Cr
in flat in flat by creek


see loc + al
for individual
holes

FROM (FT.)	TO (FT.)	KIND OF MATERIAL, COLOR, ETC. (NOTE WATER ZONES, AMOUNT, QUALITY)
0	3	Top Soil Test No. 1
3	20	Clay
20	114	Sandy Shale
114	118	Lime
118	122	Shale
122	135	Lime
135	140	Slate 15 G.P.H.
140	155	Lime
155	163	Shale
163	175	Lime
Test No. 2		
0	2	Top Soil
2	16	Clay
16	40	Shale
40	50	Sandy Shale Dry Hole
<u>Well</u>		
0	6	Top Soil
6	12	Yellow clay
12	25	Blue Drift
25	28	Silt
28	38	Sand & gravel
38	39	Lime soft
39	47	Shale


BDC
 El=910

BDB
 860

BAD
 El=831

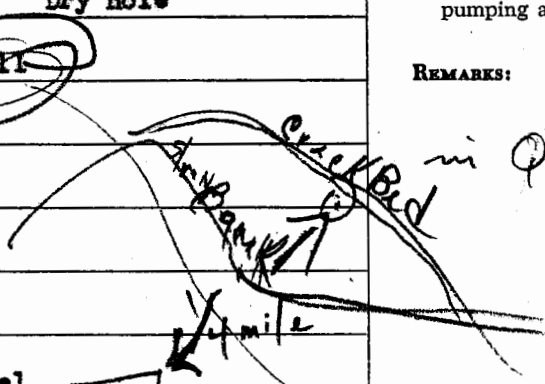

LOCATION OF WELL Topographic Sheet Tarkala
 [Show location in Section Plat] Elev. 840 ± 5

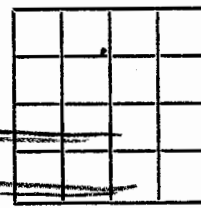

SE NE 1/4 NW 1/4 Sec. 26
 T. 10 S., R. 21 E.
 County Leaw
 BR=802 E=835