

WATER WELL RECORD


Form WWC-5

Division of Water Resources App. No.

1 LOCATION OF WATER WELL: County: LEAVONWORTH	Fraction NE 1/4 SW 1/4 NE 1/4 NW 1/4	Section Number 21	Township No. T 10 S	Range Number R 01 NE <input type="checkbox"/> W
---	--	-----------------------------	-------------------------------	--

Street/Rural Address of Well Location; if unknown, distance & direction from nearest town or intersection: If at owner's address, check here <input type="checkbox"/> 21503 HOLLINGSWORTH ROAD, TONGANOXIE, KS	Global Positioning System (GPS) information: Latitude: 39.170893 (in decimal degrees) Longitude: -95.080715 (in decimal degrees) Elevation: Datum: <input type="checkbox"/> WGS 84, <input type="checkbox"/> NAD 83, <input type="checkbox"/> NAD 27 Collection Method: <input type="checkbox"/> GPS unit (Make/Model:) <input checked="" type="checkbox"/> Digital Map/Photo, <input type="checkbox"/> Topographic Map, <input type="checkbox"/> Land Survey Est. Accuracy: <input type="checkbox"/> <3 m, <input type="checkbox"/> 3-5 m, <input type="checkbox"/> 5-15 m, <input type="checkbox"/> >15 m
--	--

2 WATER WELL OWNER: ROBERT & JEANNE DRISKO RR#, Street Address, Box #: 11021 S. GLENVIEW LANE City, State, ZIP Code : OLATHE, KS 66061	
---	--

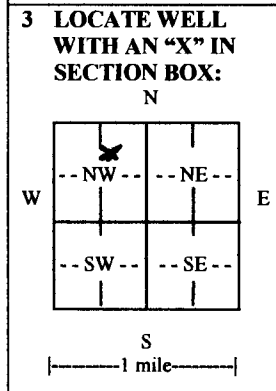

PLUGGED

4 DEPTH OF COMPLETED WELL **400** ft. **3-400' BORES**

Depth(s) Groundwater Encountered (1) **0** ft. (2) ft. (3) ft.

WELL'S STATIC WATER LEVEL ft. below land surface measured on mo/day/yr.....

Pump test data: Well water was ft. after hours pumping gpm

EST. YIELD **0** gpm. Well water was ft. after hours pumping gpm

Bore Hole Diameter **5 5/8** in. to **400** ft., and in. to ft.

WELL WATER TO BE USED AS: Public water supply Geothermal Injection well
 Domestic Feedlot Oil field water supply Dewatering Other (Specify below)
 Irrigation Industrial Domestic-lawn & garden Monitoring well **CLOSED LOOP**

Was a chemical/bacteriological sample submitted to Department? Yes No

If yes, mo/day/yr sample was submitted.....

Water well disinfected? Yes No

5 TYPE OF CASING USED: Steel PVC Other **H.D. POLYETHYLENE**.....

CASING JOINTS: Glued Clamped Welded Threaded **FUSION**

Casing diameter **1** in. to **400** ft., Diameter in. to ft., Diameter in. to ft.

Casing height above land surface **36** in., Weight **SDR11** lbs./ft., Wall thickness or gauge No. **160 PSI**.....

TYPE OF SCREEN OR PERFORATION MATERIAL: **NONE**

Steel Stainless Steel PVC Other (Specify)

Brass Galvanized Steel None used (open hole)

SCREEN OR PERFORATION OPENINGS ARE: **NONE**

Continuous slot Mill slot Gauze wrapped Torch cut Drilled holes None (open hole)
 Louvered shutter Key punched Wire wrapped Saw cut Other (specify)

SCREEN-PERFORATED INTERVALS: From ft. to ft., From ft. to ft.

GRAVEL PACK INTERVALS: From ft. to ft., From ft. to ft.

6 GROUT MATERIAL: Neat cement Cement grout Bentonite Other

Grout Intervals: From **400** ft. to **3** ft., From ft. to ft., From ft. to ft.

What is the nearest source of possible contamination:

Septic tank Lateral lines Pit privy Livestock pens Insecticide storage Other (specify below)
 Sewer lines Cesspool Sewage lagoon Fuel storage Abandoned water well
 Watertight sewer lines Seepage pit Feedyard Fertilizer storage Oil well/gas well

Direction from well Distance from well

FROM	TO	LITHOLOGIC LOG	FROM	TO	LITHO. LOG (cont.) or PLUGGING INTERVALS
0	10	SOIL/CLAY 304-321 LIME			
10	12	LIME 321-344 SHALE			
12	22	SANDSTONE 344-356 LIME			
22	129	SHALE 356-360 SHALE			
129	132	LIME 360-363 LIME	400	3	3-400' BORES PLUGGED WITH HIGH SOLID BENTONITE
132	148	SHALE 363-400 SHALE			
148	159	SANDSTONE			
159	254	SHALE			
254	280	LIME			
280	304	SHALE			

7 CONTRACTOR'S OR LANDOWNER'S CERTIFICATION: This water well was constructed, reconstructed, or plugged under my jurisdiction and was completed on (mo/day/year) **08/14/2015**..... and this record is true to the best of my knowledge and belief. Kansas Water Well Contractor's License No. **561**..... This Water Well Record was completed on (mo/day/year) **08/17/2015**..... under the business name of **EVANS ENERGY DEVELOPMENT, INC.**..... by (signature) *[Signature]*

INSTRUCTIONS: Use typewriter or ball point pen. **PLEASE PRESS FIRMLY** and **PRINT** clearly. Please fill in blanks and check the correct answers. Send one copy to Kansas Department of Health and Environment, Bureau of Water, Geology Section, 1000 SW Jackson St., Suite 420, Topeka, Kansas 66612-1367. Telephone 785-296-5524. Send one copy to WATER WELL OWNER and retain one for your records. Include fee of \$5.00 for each constructed well. Visit us at <http://www.kdheks.gov/waterwell/index.html>