

WATER WELL RECORD Form WWC-5


Division of Water Resources App. No.

Well ID

Original Record Correction Change in Well Use

1 LOCATION OF WATER WELL: County: Leavenworth Fraction SW 1/4 NW 1/4 NE 1/4 Section Number 35 Township Number T 10 S Range Number R 21 E W

2 WELL OWNER: Last Name: Miller First: Albert Street or Rural Address where well is located (if unknown, distance and direction from nearest town or intersection): If at owner's address, check here: Business: Address: 20268 199th St City: Tonganoxie State: KS ZIP: 66068

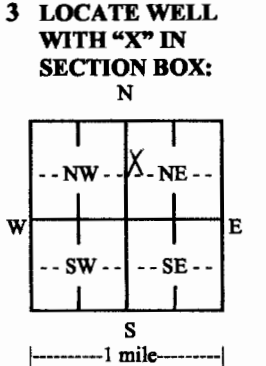

3 LOCATE WELL WITH 'X' IN SECTION BOX: N W E S 1 mile
4 DEPTH OF COMPLETED WELL: 140 ft. Depth(s) Groundwater Encountered: 1) 110 ft. 2) ft. 3) ft. or 4) Dry Well WELL'S STATIC WATER LEVEL: 52 ft. below land surface, measured on (mo-day-yr) 05/10/2022 above land surface, measured on (mo-day-yr) Pump test data: Well water was ft. after hours pumping gpm Well water was ft. after hours pumping gpm Estimated Yield: 20 gpm Bore Hole Diameter: 8.5 in. to 140 ft. and in. to ft.

5 Latitude: 39.13977 (decimal degrees) Longitude: -95.04048 (decimal degrees) Horizontal Datum: WGS 84 NAD 83 NAD 27 Source for Latitude/Longitude: GPS (unit make/model) (WAAS enabled? Yes No) Land Survey Topographic Map Online Mapper:
6 Elevation: 880 ft. Ground Level TOC Source: Land Survey GPS Topographic Map Other

7 WELL WATER TO BE USED AS: 1. Domestic: Household Lawn & Garden Livestock Irrigation Feedlot Industrial 2. Public Water Supply: well ID Dewatering: how many wells? Aquifer Recharge: well ID Monitoring: well ID Environmental Remediation: well ID Air Sparge Soil Vapor Extraction Recovery Injection Oil Field Water Supply: lease Test Hole: well ID Cased Uncased Geotechnical Geothermal: how many bores? a) Closed Loop Horizontal Vertical b) Open Loop Surface Discharge Inj. of Water Other (specify):

Was a chemical/bacteriological sample submitted to KDHE? Yes No If yes, date sample was submitted: Water well disinfected? Yes No

8 TYPE OF CASING USED: Steel PVC Other CASING JOINTS: Glued Clamped Welded Threaded Casing diameter 5 in. to 140 ft., Diameter in. to ft., Diameter in. to ft. Casing height above land surface 18 in. Weight lbs./ft. Wall thickness or gauge No. SCH 40 TYPE OF SCREEN OR PERFORATION MATERIAL: Steel Stainless Steel Fiberglass PVC Other (Specify) Brass Galvanized Steel Concrete tile None used (open hole) SCREEN OR PERFORATION OPENINGS ARE: Continuous Slot Mill Slot Gauze Wrapped Torch Cut Drilled Holes Other (Specify) Louvered Shutter Key Punched Wire Wrapped Saw Cut None (Open Hole) SCREEN-PERFORATED INTERVALS: From 110 ft. to 130 ft., From ft. to ft., From ft. to ft. GRAVEL PACK INTERVALS: From 30 ft. to 140 ft., From ft. to ft., From ft. to ft.

9 GROUT MATERIAL: Neat cement Cement grout Bentonite Other Grout Intervals: From 0 ft. to 30 ft., From ft. to ft., From ft. to ft. Nearest source of possible contamination: Septic Tank Lateral Lines Pit Privy Livestock Pens Insecticide Storage Sewer Lines Cess Pool Sewage Lagoon Fuel Storage Abandoned Water Well Watertight Sewer Lines Seepage Pit Feedyard Fertilizer Storage Oil Well/Gas Well Other (Specify) None Yet Direction from well? n/a Distance from well? n/a ft.

Table with 6 columns: FROM, TO, LITHOLOGIC LOG, FROM, TO, LITHO. LOG (cont.) or PLUGGING INTERVALS. Rows include Topsoil, Clay, Sandy Clay, Sandstone, Sandy Shale, Shale, Sandy Shale, Sandstone, Sandy Limestone. Includes a Notes section.

11 CONTRACTOR'S OR LANDOWNER'S CERTIFICATION: This water well was constructed, reconstructed, or plugged under my jurisdiction and was completed on (mo-day-year) 05/10/2022 and this record is true to the best of my knowledge and belief. Kansas Water Well Contractor's License No. 595 This Water Well Record was completed on (mo-day-year) 05/25/2022 under the business name of Jesse Yoakum Well Drilling Signature