


1 LOCATION OF WATER WELL: Fraction NW 1/4 NW 1/4 NE 1/4 Section Number 23 Township Number T 10 S Range Number R 22 E/W  
 County: LEAVENWORTH

Distance and direction from nearest town or city street address of well if located within city?

2 north, 5/8 east of Basehor

2 WATER WELL OWNER: Jeff Douglas  
 RR#, St. Address, Box #: 14811 Hollingsworth Rd. Board of Agriculture, Division of Water Resources  
 City, State, ZIP Code: Basehor, KS 66007 Application Number:

3 LOCATE WELL'S LOCATION WITH AN "X" IN SECTION BOX:

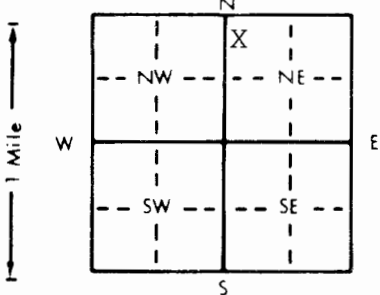

4 DEPTH OF COMPLETED WELL: 150' ft. ELEVATION:

Depth(s) Groundwater Encountered 1. . . . . ft. 2. . . . . ft. 3. . . . . ft.

WELL'S STATIC WATER LEVEL: 85' ft. below land surface measured on mo/day/yr 7-17-95

Pump test data: Well water was . . . . . ft. after . . . . . hours pumping . . . . . gpm

Est. Yield: 20 gpm Well water was . . . . . ft. after . . . . . hours pumping . . . . . gpm

Bore Hole Diameter: 8 3/4 in. to . . . . . ft., and . . . . . in. to . . . . . ft.

WELL WATER TO BE USED AS: 5 Public water supply 8 Air conditioning 11 Injection well

1 Domestic 3 Feedlot 6 Oil field water supply 9 Dewatering 12 Other (Specify below)

2 Irrigation 4 Industrial 7 Lawn and garden only 10 Monitoring well

Was a chemical/bacteriological sample submitted to Department? Yes . . . . . No . . . . . If yes, mo/day/yr sample was submitted

Water Well Disinfected? Yes . . . . . No

5 TYPE OF BLANK CASING USED: 5 Wrought iron 8 Concrete tile CASING JOINTS: Glued . . . . . Clamped . . . . .

1 Steel 3 RMP (SR) 6 Asbestos-Cement 9 Other (specify below) Welded . . . . .

2 PVC 4 ABS 7 Fiberglass . . . . . Threaded . . . . .

Blank casing diameter: 5" in. to 0-130 ft. Dia 5" in. to 135-140 ft. Dia . . . . . in. to . . . . . ft.

Casing height above land surface: 24" in. weight 2.82 lbs./ft. Wall thickness or gauge No. 258

TYPE OF SCREEN OR PERFORATION MATERIAL: 7 PVC 10 Asbestos-cement

1 Steel 3 Stainless steel 5 Fiberglass 8 RMP (SR) 11 Other (specify) . . . . .

2 Brass 4 Galvanized steel 6 Concrete tile 9 ABS 12 None used (open hole)

SCREEN OR PERFORATION OPENINGS ARE: 5 Gauzed wrapped 8 Saw cut 11 None (open hole)

1 Continuous slot 3 Mill slot 6 Wire wrapped 9 Drilled holes

2 Louvered shutter 4 Key punched 7 Torch cut 10 Other (specify) . . . . .

SCREEN-PERFORATED INTERVALS: From 130 ft. to 135 ft. From . . . . . ft. to . . . . . ft.

From 140 ft. to 150 ft. From . . . . . ft. to . . . . . ft.

GRAVEL PACK INTERVALS: From 24 ft. to 150 ft. From . . . . . ft. to . . . . . ft.

From . . . . . ft. to . . . . . ft. From . . . . . ft. to . . . . . ft.

6 GROUT MATERIAL: 1 Neat cement 2 Cement grout 3 Bentonite 4 Other

Grout Intervals: From 4 ft. to 24 ft. From . . . . . ft. to . . . . . ft. From . . . . . ft. to . . . . . ft.

What is the nearest source of possible contamination: 10 Livestock pens 14 Abandoned water well

1 Septic tank 4 Lateral lines 7 Pit privy 11 Fuel storage 15 Oil well/Gas well

2 Sewer lines 5 Cess pool 8 Sewage lagoon 12 Fertilizer storage 16 Other (specify below)

3 Watertight sewer lines 6 Seepage pit 9 Feedyard 13 Insecticide storage

Direction from well? south How many feet? 250'

FROM	TO	LITHOLOGIC LOG	FROM	TO	PLUGGING INTERVALS
0	1	Top Soil			
1	35	Clay-Brown			
35	60	Clay-Blue			
60	61	Boulder			
61	128	Clay-Blue			
128	135	Chert 1/4x1/2			
135-142		Clay-Blue			
142	145	Limestone-Grey			
145	150	Shale-Grey			

7 CONTRACTOR'S OR LANDOWNER'S CERTIFICATION: This water well was (1) constructed, (2) reconstructed, or (3) plugged under my jurisdiction and was completed on (mo/day/year) 7-17-95 and this record is true to the best of my knowledge and belief. Kansas Water Well Contractor's License No. 182 This Water Well Record was completed on (mo/day/yr) 7-21-95 under the business name of STRADER DRILLING CO., INC. by (signature) *Ralph Strader*