


1 LOCATION OF WATER WELL: Fraction SE 1/4 NE 1/4 NW 1/4 Section Number 30 Township Number T 10 S Range Number R 22 (EW)
 County: Lewinworth

Distance and direction from nearest town or city street address of well if located within city?
3.5 West and 1.75 North of Basehor KS

2 WATER WELL OWNER: Doug Porter
 RR#, St. Address, Box #: 18225 Donahoe Board of Agriculture, Division of Water Resources
 City, State, ZIP Code: Tonganoxie, KS 66086 Application Number:

3 LOCATE WELL'S LOCATION WITH AN "X" IN SECTION BOX:

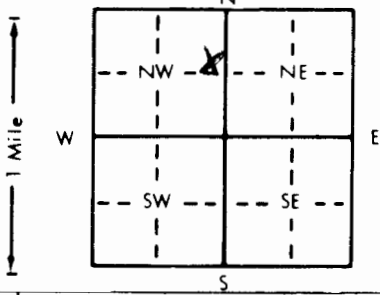

4 DEPTH OF COMPLETED WELL: 105 ft. ELEVATION:

Depth(s) Groundwater Encountered 1. 80 ft. 2. ft. 3. ft.
 WELL'S STATIC WATER LEVEL 74 ft. below land surface measured on mo/day/yr 5-16-96

Pump test data: Well water was ft. after hours pumping gpm
 Est. Yield 16 gpm: Well water was ft. after hours pumping gpm
 Bore Hole Diameter 7 3/8 in. to ft. and in. to ft.
 WELL WATER TO BE USED AS: 5 Public water supply 8 Air conditioning 11 Injection well
 Domestic 3 Feedlot 6 Oil field water supply 9 Dewatering 12 Other (Specify below)
 2 Irrigation 4 Industrial 7 Lawn and garden only 10 Monitoring well

Was a chemical/bacteriological sample submitted to Department? Yes No X; If yes, mo/day/yr sample was submitted
 Water Well Disinfected? Yes X No

5 TYPE OF BLANK CASING USED: 5 Wrought iron 8 Concrete tile CASING JOINTS: Glued X Clamped
 1 Steel 3 RMP (SR) 6 Asbestos-Cement 9 Other (specify below) Welded
 PVC 4 ABS 7 Fiberglass Threaded

Blank casing diameter 5 in. to 9.5 ft. Dia. in. to ft. Dia. in. to ft.
 Casing height above land surface 24 in. weight 200 lbs. lbs./ft. Wall thickness or gauge No.

TYPE OF SCREEN OR PERFORATION MATERIAL: PVC 10 Asbestos-cement
 1 Steel 3 Stainless steel 5 Fiberglass 8 RMP (SR) 11 Other (specify)
 2 Brass 4 Galvanized steel 6 Concrete tile 9 ABS 12 None used (open hole)

SCREEN OR PERFORATION OPENINGS ARE: 5 Gauzed wrapped 8 Saw cut 11 None (open hole)
 1 Continuous slot Mill slot 6 Wire wrapped 9 Drilled holes
 2 Louvered shutter 4 Key punched 7 Torch cut 10 Other (specify)

SCREEN-PERFORATED INTERVALS: From 95 ft. to 105 ft. From ft. to ft.
 From ft. to ft. From ft. to ft.
 GRAVEL PACK INTERVALS: From 20 ft. to 105 ft. From ft. to ft.
 From ft. to ft. From ft. to ft.

6 GROUT MATERIAL: 1 Neat cement 2 Cement grout Bentonite 4 Other
 Grout Intervals: From 0 ft. to 20 ft. From ft. to ft. From ft. to ft.

What is the nearest source of possible contamination: NONE AT TIME OF
 1 Septic tank 4 Lateral lines Drilling 7 Pit privy 10 Livestock pens 14 Abandoned water well
 2 Sewer lines 5 Cess pool 8 Sewage lagoon 11 Fuel storage 15 Oil well/Gas well
 3 Watertight sewer lines 6 Seepage pit 9 Feedyard 12 Fertilizer storage 16 Other (specify below)
 13 Insecticide storage

Direction from well? How many feet?

| FROM | TO | LITHOLOGIC LOG | FROM | TO | PLUGGING INTERVALS |
|------|-----|----------------------|------|----|--------------------|
| 0 | 30 | Sandstone (Brown) | | | |
| 30 | 32 | Shale (Grey) | | | |
| 32 | 80 | SAND STONE (Brown) | | | |
| 80 | 85 | Sand Brown | | | |
| 85 | 90 | Sandy Lime (White) | | | |
| 90 | 105 | Sand (White + Brown) | | | |
| 105 | - | Lime | | | |

7 CONTRACTOR'S OR LANDOWNER'S CERTIFICATION: This water well was constructed, (2) reconstructed, or (3) plugged under my jurisdiction and was completed on (mo/day/year) 5-16-96 and this record is true to the best of my knowledge and belief. Kansas Water Well Contractor's License No. 561 This Water Well Record was completed on (mo/day/yr) 5-20-96 under the business name of EVANS ENERGY Dev Inc. by (signature) [Signature]