


1 LOCATION OF WATER WELL: County: Leavenworth Fraction: NE 1/4 NW 1/4 NE 1/4 Section Number: 21 Township Number: T 10 S Range Number: R 22 (EW)

Distance and direction from nearest town or city street address of well if located within city?
From 24.40 N 4 miles then west 3 T. to on South side

2 WATER WELL OWNER: Jason Long
 RR#, St. Address, Box #: 16551 Hollingsworth Rd. Board of Agriculture, Division of Water Resources
 City, State, ZIP Code: Boscher KS 66007 Application Number:

3 LOCATE WELL'S LOCATION WITH AN "X" IN SECTION BOX:

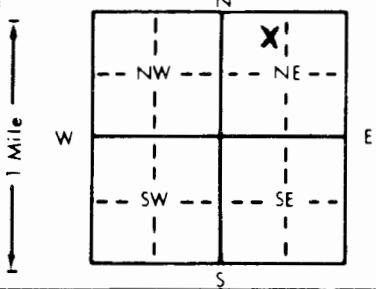

4 DEPTH OF COMPLETED WELL: 112 ft. ELEVATION:

Depth(s) Groundwater Encountered: 1.26 35 ft. 2. 45-162 ft. 3. _____ ft.

WELL'S STATIC WATER LEVEL: 4.2 ft. below land surface measured on mo/day/yr Nov 7 94

Pump test data: Well water was _____ ft. after _____ hours pumping _____ gpm

Est. Yield 1.5 gpm; Well water was _____ ft. after _____ hours pumping _____ gpm

Bore Hole Diameter 5 7/8 in. to 20 ft. and 7 7/8 in. to 120 ft.

WELL WATER TO BE USED AS:
 1 Domestic 3 Feedlot 6 Oil field water supply 9 Dewatering 12 Other (Specify below)
 2 Irrigation 4 Industrial 7 Lawn and garden only 10 Monitoring well

Was a chemical/bacteriological sample submitted to Department? Yes _____ No _____; If yes, mo/day/yr sample was submitted _____

Water Well Disinfected? Yes No _____

5 TYPE OF BLANK CASING USED: 1 Steel 3 RMP (SR) 5 Wrought iron 8 Concrete tile CASING JOINTS: Glued Clamped _____

2 PVC 4 ABS 6 Asbestos-Cement 9 Other (specify below) Welded _____
 7 Fiberglass Threaded _____

Blank casing diameter: 5 in. to 10 1/2 ft., Dia _____ in. to _____ ft., Dia _____ in. to _____ ft.
 Casing height above land surface: 30 in., weight 200 lbs lbs./ft. Wall thickness or gauge No. _____

TYPE OF SCREEN OR PERFORATION MATERIAL: 7 PVC 10 Asbestos-cement

1 Steel 3 Stainless steel 5 Fiberglass 8 RMP (SR) 11 Other (specify) _____
 2 Brass 4 Galvanized steel 6 Concrete tile 9 ABS 12 None used (open hole)

SCREEN OR PERFORATION OPENINGS ARE: 5 Gauzed wrapped 8 Saw cut 11 None (open hole)

1 Continuous slot 3 Mill slot 6 Wire wrapped 9 Drilled holes
 2 Louvered shutter 4 Key punched 7 Torch cut 10 Other (specify) _____

SCREEN-PERFORATED INTERVALS: From 10 1/2 ft. to 112 ft., From _____ ft. to _____ ft.
 From _____ ft. to _____ ft., From _____ ft. to _____ ft.

GRAVEL PACK INTERVALS: From 112 ft. to 48 ft., From 35 ft. to 20 ft.
 From _____ ft. to _____ ft., From _____ ft. to _____ ft.

6 GROUT MATERIAL: 1 Neat cement 2 Cement grout 3 Bentonite 4 Other _____

Grout Intervals: From 48 ft. to 35 ft., From 20 ft. to 0 ft., From _____ ft. to _____ ft.

What is the nearest source of possible contamination:
 1 Septic tank 4 Lateral lines 7 Pit privy 10 Livestock pens 14 Abandoned water well
 2 Sewer lines 5 Cess pool 8 Sewage lagoon 11 Fuel storage 15 Oil well/Gas well
 3 Watertight sewer lines 6 Seepage pit 9 Feedyard 12 Fertilizer storage 16 Other (specify below)
 13 Insecticide storage

Direction from well? E How many feet? 100

FROM	TO	LITHOLOGIC LOG	FROM	TO	PLUGGING INTERVALS
0	16	Soil/clay			
16	26	Sand			
26	34	Gravel			
34	35	Gravel + Limestone			
35	50	Shale			
50	65	Sandstone			
65	102	Sandstone			
102	120	Limestone			

7 CONTRACTOR'S OR LANDOWNER'S CERTIFICATION: This water well was (1) constructed, (2) reconstructed, or (3) plugged under my jurisdiction and was completed on (mo/day/year) 11-9-94 and this record is true to the best of my knowledge and belief. Kansas Water Well Contractor's License No. 561 This Water Well Record was completed on (mo/day/yr) 11-11-94 under the business name of Evans Energy Dev. Inc. by (signature) Scott B. Evans