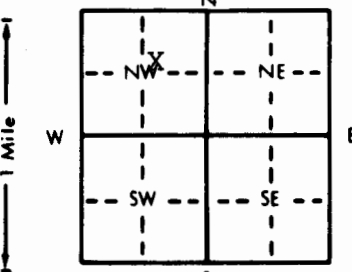


1 LOCATION OF WATER WELL: Fraction SW 1/4 NE 1/4 NW 1/4 Section Number 10 Township Number T 10S S Range Number R 22E EW
 County: LEAVENWORTH

Distance and direction from nearest town or city street address of well if located within city?
 3/4 mile west, 1/2 north of Fairmont

2 WATER WELL OWNER: Don Trowbridge
 RR#, St. Address, Box #: ~~XXXXXX~~ 1420 N. 86th Breuer job Board of Agriculture, Division of Water Resources
 City, State, ZIP Code: Kansas City, KS 66112 Application Number:

3 LOCATE WELL'S LOCATION WITH AN "X" IN SECTION BOX:

 4 DEPTH OF COMPLETED WELL... 168' ft. ELEVATION:
 Depth(s) Groundwater Encountered 1. ft. 2. ft. 3. ft.
 WELL'S STATIC WATER LEVEL .. 57' ft. below land surface measured on mo/day/yr ... 10/20/97
 Pump test data: Well water was ft. after hours pumping gpm
 Est. Yield .. 13 ... gpm: Well water was ft. after hours pumping gpm
 Bore Hole Diameter. 8 3/4 .in. to ft., and in. to ft.
 WELL WATER TO BE USED AS: 5 Public water supply 8 Air conditioning 11 Injection well
 1 Domestic 3 Feedlot 6 Oil field water supply 9 Dewatering 12 Other (Specify below)
 2 Irrigation 4 Industrial 7 Lawn and garden only 10 Monitoring well
 Was a chemical/bacteriological sample submitted to Department? Yes.....No.....X...; If yes, mo/day/yr sample was submitted
 Water Well Disinfected? Yes X No

5 TYPE OF BLANK CASING USED: 5 Wrought iron 8 Concrete tile CASING JOINTS: Glued X Clamped
 1 Steel 3 RMP (SR) 6 Asbestos-Cement 9 Other (specify below) Welded
 2 PVC 4 ABS 7 Fiberglass Threaded
 Blank casing diameter 5" in. to ... 0-128 ... ft., Dia. in. to ft., Dia. in. to ft.
 Casing height above land surface. 24" in., weight ... 2.82 lbs./ft. Wall thickness or gauge No. 258
 TYPE OF SCREEN OR PERFORATION MATERIAL: 7 PVC 10 Asbestos-cement
 1 Steel 3 Stainless steel 5 Fiberglass 8 RMP (SR) 11 Other (specify)
 2 Brass 4 Galvanized steel 6 Concrete tile 9 ABS 12 None used (open hole)
 SCREEN OR PERFORATION OPENINGS ARE: 5 Gauzed wrapped 8 Saw cut 11 None (open hole)
 1 Continuous slot 3 Mill slot 6 Wire wrapped 9 Drilled holes
 2 Louvered shutter 4 Key punched 7 Torch cut 10 Other (specify)
 SCREEN-PERFORATED INTERVALS: From 128 ft. to 168 ft., From ft. to ft.
 From ft. to ft., From ft. to ft.
 GRAVEL PACK INTERVALS: From 24 ft. to 168 ft., From ft. to ft.
 From ft. to ft., From ft. to ft.

6 GROUT MATERIAL: 1 Neat cement 2 Cement grout 3 Bentonite 4 Other
 Grout Intervals: From 4 ft. to ... 24 ft., From ft. to ft., From ft. to ft.
 What is the nearest source of possible contamination:
 1 Septic tank 4 Lateral lines 7 Pit privy 10 Livestock pens 14 Abandoned water well
 2 Sewer lines 5 Cess pool 8 Sewage lagoon 11 Fuel storage 15 Oil well/Gas well
 3 Watertight sewer lines 6 Seepage pit 9 Feedyard 12 Fertilizer storage 16 Other (specify below)
 13 Insecticide storage
 Direction from well? east How many feet? 250'

| FROM | TO | LITHOLOGIC LOG | FROM | TO | PLUGGING INTERVALS |
|------|-----|----------------------------------|------|----|--------------------|
| 0 | 2 | Top Soil | | | |
| 2 | 37 | Clay-Brown | | | |
| 37 | 42 | Fine Sand-Coarse Sand-Med Gravel | | | |
| 42 | 43 | Boulders-Red | | | |
| 43 | 70 | Shale-Grey | | | |
| 70 | 76 | Shaley Limestone-Grey | | | |
| 76 | 98 | Shale-Grey | | | |
| 98 | 120 | Shaley Limestone-Grey | | | |
| 120 | 125 | Limestone-Grey | | | |
| 125 | 130 | Shale-Grey | | | |
| 130 | 161 | Sandstone-Grey | | | |

7 CONTRACTOR'S OR LANDOWNER'S CERTIFICATION: This water well was (1) constructed, (2) reconstructed, or (3) plugged under my jurisdiction and was completed on (mo/day/year) ... 10/20/97 ... and this record is true to the best of my knowledge and belief. Kansas Water Well Contractor's License No. 182 This Water Well Record was completed on (mo/day/yr) 11-20-97 under the business name of STRADER DRILLING CO., INC. by (signature) Dale Ashburn

OFFICE USE ONLY
T
R
EM
SEC
1/4
1/4
1/4