Topprop

BRT

WATER WELL RECORD

DRILLERS LOG OF WELL

FROM (FŢ.)	TD (FT,.)	KIND OF MATERIAL, COLOR, ETC. (NOTE WATER ZONES, AMOUNT, QUALITY)
0	3 .	Top-Soil
3.	.18	Olay · · ·
78	.24	Sandy Clay
24	29	Sand-
29	36	Sandy Shale-
36	40	Sandy Gravel (Miter)
40	47	Sandy Shale
47	60	Shale
60		Lime
60		T. D.
		•

"To preserve water well information and to promote the conservation, protection, and development of ground-water resources."

Well Owner Wr A	Tuttle
·	
Address 1 110 b	5/4 mi. S. of Basehor, ks.
Drilling Contractor_Bi	reuer Drilling Co.
Basehor, kansı	
Date Drilled 7/28/	5
Method of Drilling	(Cable tool, rotary, reverse rotary, etc.)
(Amount, Size, Setting-	A steel 23 6 steel New, Used—Steel, Calv.—Gage or Weight)
Sames Data (#f. anni)	
Screen Data (if any): _	(Length, Diameter, Slot Size, Setting)
	ater on completed well (Static Level) is
Tested Yield: _over	(Land Surface, Top of Casing, Etc.) gallons per (Min., Hour)
TESTED YIELD:as determined by	delow Land Surface, Top of Casing, Etc.) gallons per(Min., Hour) Be 11 (Beiling, Test Pumping, Etc.)

CHARLES TO SECOND

10-57-5M SETS


KANSAS WELL SCHEDULE


Card 1

Record by KLINS CAN H Date: 4-17-20 Project: 10 P-10 State: KAN K County: Leav	72
Latitude: Longitude: Accuracy: Owner's well no:	
Togetion: 1 SE NE SE no sec 3-3 T/O N RZ-Z E Well number: 1 0 22 E3 3DAL	<u> </u>
S. W. 4 5 6 7 8 9 10 11 12 1. Owner: Roman address	14 no.
Owner: R B I N T U T T L E	, 44
Driller: Date drilled: 7-28-60	<u></u>
Topography, well site: (D) (F) (L) (R) (S) (T) (U) Spring; or depth of well: 6 0 0 0 0 0 0 0 0 0 0 0 0 0 0 0 0 0 0	50
Diameter: 6 Depth cased: 60 Spring, or 5 Spr	
Pump setting: Use of well: Domestic, stock, irrigation, industrial, public supply, observation, none, test	_ []
Water level: 25 above lsd 63 64 65 accuracy 66 date measured 67 68 69 water level records avail.	70
Description MP: OP Caning 3.0 by authors ab	ove lsd low
Yield: 3 6 3 6 75 Pumping period: Specific capacity: gpm/ft. dd 7	8 79
Pumpage and other data available:	_ 🔲
Card 2	
Coefficient trans: Coefficient storage: Coefficient perm.:	gpd/ft ² .
gpd/ft 15 16 17 18 19 20 Aquifer, system or series	
21 22 23 Aquifer, units	24
Aquifer, thickness: Aquifer, length of well open to: Aquifer, depth to top of: Aquifer, origin: Aquifer, origin:	
Aquifer, lithology of:	
Bedrock, system:	
Surficial material: Log data avail:	
lithology infiltration characteristics Quality of water data available:	64
	59 70
THE FOLLOWING DATA ARE USED ON THE NATIONAL WELL SCHEDULE Ownership (C) (F) (M) (N) (P) (S) (W)	
Ownership (C) (F) (M) (N) (P) (S) (W) category: County, Federal Gov't., City, Corp. or Co., Private, State Agency, Water Dist.	71
Method drilled: (A) (B) (C) (D) (V) (H) (J) (R) (T) (S) Air, bored, cable, dug, driven, hyd. rotary, jetted, rev. rotary, trenching, spring,	72
Physiographic province: 73 74 Section:	
Drainage basin: Depth to basement: 75 76 Subbasin: Depth to basement: 77 78 79 source of data (basement)	80
Quadrangle	

Well no.___

Well log							
			<u> </u>				
			ļ				
			 				
			 -				
			·				
				-			
· ·							
	V 12						
			\vdash				
			-				
		_	 				
		_					
			-				
			 				

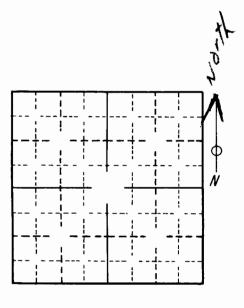

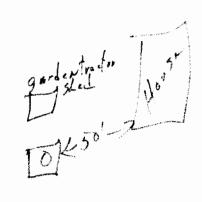

Co Road