195

USE TYPEWRITER OR BALL POINT PEN-PRESS FIRMLY, PRINT CLEARLY.

WATER WELL RECORD
KSA 82a-1201-1215

ABB

Kansas Department of Health and Environment-Division of Environment
(Water well Contractors)
Topeka, Kansas 66620

1. Location of well:	County	Fraction	Section number	Township number	Range number
	LEAVENWORTH	NW 1/4 NW 1/4 NE 1/4	8	T 10 S	R 22 E W

2. Distance and direction from nearest town or city: 4 3/4 E.
Street address of well location if in city: TARBLO, KS.

3. Owner of well: DON WACKER
R.R. or street:
City, state, zip code: RR3 - LEAVENWORTH - BOX 268

4. Locate with "X" in section below:

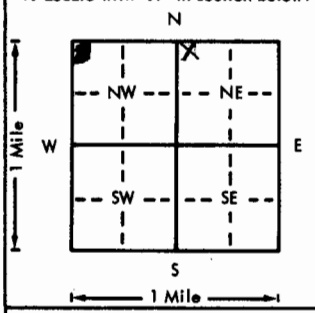

Sketch map:

6. Bore hole dia. 8 in. Completion date
Well depth 100 ft. 3-10-76

7. __ Cable tool ✓ Rotary __ Driven __ Dug
__ Hollow rod __ Jetted __ Bored __ Reverse rotary

8. Use: ✓ Domestic __ Public supply __ Industry
__ Irrigation __ Air conditioning __ Stock
__ Lawn __ Oil field water __ Other

9. Casing: Material PVC Height: Above or below
Threaded ___ Welded ___ Surface 24 in.
RMP ___ PVC 96 Weight 2.58 lbs./ft.
Dia. 5 in. to 100 ft. depth Wall Thickness: inches or
Dia. ___ in. to ___ ft. depth gage No. 1258

5. Type and color of material	From	To
TOP SOIL	0	4
BROWN CLAY	4	25
COURSE SAND	25	30
GREY SHALE	30	55
GREY LIME	55	59
GREY SHALE	59	90
BLACK SHALE	90	94
GREY SHALE	94	100

(Use a second sheet if needed)

10. Screen: Manufacturer's name RUMPCO
Type PVC Dia. 5"
Slot/gauze .025 Length 10
Set between 23 ft. and 33 ft.
___ ft. and ___ ft.
Gravel pack? ✓ Size range of material .030x.080

11. Static water level: mo./day/yr.
25 ft. below land surface Date 3-10-76

12. Pumping level below land surfaces: AIRTEST
___ ft. after ___ hrs. pumping ___ g.p.m.
___ ft. after ___ hrs. pumping ___ g.p.m.
Estimated maximum yield 3 g.p.m.

13. Water sample submitted: mo./day/yr.
__ Yes ✓ No Date

14. Well head completion: Capped
__ Pitless adapter 24 inches above grade

15. Well grouted? ✓
With: ✓ Neat cement __ Bentonite __ Concrete
Depth: From 0 ft. to 20 ft.

16. Nearest source of possible contamination:
ft. 100 Direction E Type SEPTIC TANK
Well disinfected upon completion? __ Yes __ No

17. Pump: ✓ Not installed
Manufacturer's name
Model number HP Volts
Length of drop pipe ft. capacity g.p.m.
Type:
__ Submersible __ Turbine
__ Jet __ Reciprocating
__ Centrifugal __ Other

18. Elevation: 946
Topography:
✓ Hill
__ Slope
__ Upland
__ Valley

19. Remarks: OWNER WILL INSTAL SLAB

20. Water well contractor's certification:
This well was drilled under my jurisdiction and this report is true to the best of my knowledge and belief.
Stadler Daly Co Inc. 182
Business name License No.
Address RR1 Holton, KS
Signed Dale Ashman Date 3-12
Authorized representative

T 10 R 22 W Sec 8 NW NW NW

Forward the white, blue and pink copies to the Department of Health and Environment

Form WWC-5

BR elev = 916 ▽ = 921