


1 LOCATION OF WATER WELL: County: **Leavenworth** Fraction: **SW 1/4 NE 1/4 NW 1/4** Section Number: **10** Township Number: **T 10 S** Range Number: **R 22 EW**

Distance and direction from nearest town or city street address of well if located within city? **4 miles north of Bascher, Kansas**

2 WATER WELL OWNER: **James C. Johnson** RR#, St. Address, Box #: **Route 3** City, State, ZIP Code: **Leavenworth, Kansas 66048** Board of Agriculture, Division of Water Resources Application Number:

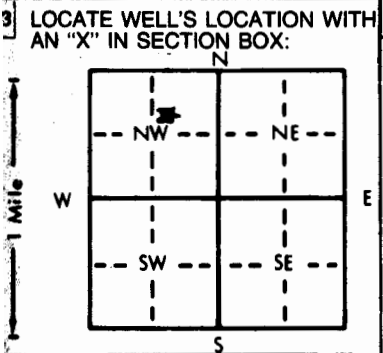

3 LOCATE WELL'S LOCATION WITH AN "X" IN SECTION BOX: 4 DEPTH OF COMPLETED WELL: **116** ft. ELEVATION: **116** ft. Depth(s) Groundwater Encountered 1. **31** ft. 2. **95** ft. 3. **95** ft. WELL'S STATIC WATER LEVEL: **26** ft. submitted to Department? Yes **XX** No **XX** If yes, mo/day/yr sample was submitted **XX** Water Well Disinfected? Yes **XX** No **XX**

5 TYPE OF BLANK CASING USED: 1 Steel 3 RMP (SR) 5 Wrought iron 8 Concrete tile CASING JOINTS: Glued **XX** Clamped 2 PVC 4 ABS 7 Fiberglass 9 Other (specify below) Welded Threaded. Blank casing diameter **5** in. to **116** ft. Dia. **200** in. to **116** ft. Dia. Casing height above land surface **18** in., weight **200** lbs./ft. Wall thickness or gauge No. **265**. TYPE OF SCREEN OR PERFORATION MATERIAL: 1 Steel 3 Stainless steel 5 Fiberglass 7 PVC 10 Asbestos-cement 2 Brass 4 Galvanized steel 6 Concrete tile 8 RMP (SR) 11 Other (specify) 12 None used (open hole) SCREEN OR PERFORATION OPENINGS ARE: 1 Continuous slot 3 Mill slot 5 Gauzed wrapped 8 Saw cut 11 None (open hole) 2 Louvered shutter 4 Key punched 6 Wire wrapped 9 Drilled holes 7 Torch cut 10 Other (specify) SCREEN-PERFORATED INTERVALS: From **25** ft. 

What is the nearest source of possible contamination: 1 Septic tank 4 Lateral lines 7 Pit privy 10 Livestock pens 14 Abandoned water well 2 Sewer lines 5 Cess pool 8 Sewage lagoon 11 Fuel storage 15 Oil well/Gas well 3 Watertight sewer lines 6 Seepage pit 9 Feedyard 12 Fertilizer storage 16 Other (specify below) 13 Insecticide storage Direction from well? **SE** How many feet? **200**

FROM	TO	LITHOLOGIC LOG	FROM	TO	LITHOLOGIC LOG
0	2	Top Soil			
2	27	Sandy Clay			
27	36	Sand			
36	42	Shale			
42	95	Sandy Shale			
95	101	Sandstone			
101	106	Sandy Shale			

7 CONTRACTOR'S OR LANDOWNER'S CERTIFICATION: This water well was **(1)** constructed, (2) reconstructed, or (3) plugged under my jurisdiction and was completed on (mo/day/year) **2-26-85** and this record is true to the best of my knowledge and belief. Kansas Water Well Contractor's License No. **174** This Water Well Record was completed on (mo/day/yr) **2-26-85** under the business name of **BRUSH, INC.** by (signature) **Allen H. Bush**

INSTRUCTIONS: Use typewriter or ball point pen, PLEASE PRESS FIRMLY and PRINT clearly. Please fill in blanks, underline or circle the correct answers. Send top three copies to Kansas Department of Health and Environment, Division of Environment, Environmental Geology Section, Topeka, KS 66620. Send one to WATER WELL OWNER and retain one for your records.